

Dec 17 1 34 PM '99

Van Buren County Remonumentation Program  
LAND CORNER RECORDATION CERTIFICATE

Filing Requirement of Act 74, Mich. P.A. 1970

For corners in W 1/4 corner, Section 17, Waverly Twp.

*Mark A. Smith*  
VAN BUREN CO  
REGISTER OF DEEDS

9.00

Van Buren (County)	Located In:	Corner Code #
1. Public Land Survey	T <u>2S</u> R <u>14W</u>	<u>C - 6</u>
	T _____ R _____	_____
	T _____ R _____	_____
	T _____ R _____	_____
2. Property Controlling in Section	S _____ T _____ R _____	_____
	S _____ T _____ R _____	_____
3. Miscellaneous Property in Sec.	S _____ T _____ R _____	_____
	S _____ T _____ R _____	_____

DEC 28 1999

SECTION

Register of Deeds Stamp & File  
Number

8815 12/17 0104 10SURVEY

4. Lot No. \_\_\_\_\_, Recorded Plat \_\_\_\_\_  
5. Private Claims \_\_\_\_\_

I, Daniel B. Zwar, in a field survey on Dec. 4, 19 99 do hereby state that under requirements of P.A. 74, Michigan P.A. of 1970, the corner points mentioned in lines 1 and 2 above were in conformance with regulations and rules therefore as required in the current manual of survey instructions of the United States Department of the Interior, Bureau of Land Management or by a decree of a Court of Law and /or that the corner points mentioned in lines 3, 4 and 5 above were in conformance with the rules of the Michigan Board of Land Surveyors or by a Decree of a Court of Law; established, re-established, monumented, recovered, found as expressed below:

	A	B	C	D	E	F	G	H	I	J	K	L	M
1													
2	6		5		4		3		2		1		
3													
4	7		8		9		10		11		12		
5													
6	18		17		16		15		14		13		
7													
8	19		20		21		22		23		24		
9													
10	30		29		28		27		26		25		
11													
12	31		32		33		34		35		36		
13													

NOTE: Not more than 2 corners, all in the same town and range, may be recorded on this certificate.

A. Description of original monument and accessories and/or subsequent restoration:

1830 - GW Harrison, D.S. - Ran North between Section 17 & 18, 40 chains and set post.  
12" Sugar - S 40° E - 9 Links, 24" Lynn - N 38° W - 27 Links.

1991 - G.J. Mitchell - Found Washer Crank P.P. - WSW - 36.90', P.P. - ESE - 34.55'; P.P. - NE - 47.5'; Centerline road - North 6' more or less.

B. Description of corner evidence found and/or method applied in restoring or reestablishing corner:

1999 - D.B. Zwar - Found "Washing Machine Crank" with Mitchell witnesses. Straddled and removed, nothing else here.

C. Description of monument for corner and accessories established to perpetuate locating the position of the corner:

Placed standard Harrison monument to Iron Bar location 6" deep in gravel road and in mon. box.

Ratified by Peer Group in  
accordance with P.A. 345 of 1990  
Van Buren County Surveyor


Date 12-16-99 D. B. Z.

New Witnesses:

Imp Pole V347-15 N 50° E 47.38'; 12" Elm S 66° E 19.24'; 8" Maple S 08° W 27.11'; Imp Pole V347-1 S 70° W 36.35'; SW corner Sec 17, South 2617.16; NW corner Section 17 North 2628.55; Center Section 17 East 2641.59'.

This location is accepted as the best available evidence of the position of the original corner.

Signed by Daniel B. Zwar  
Surveyor's Michigan License No. 28435

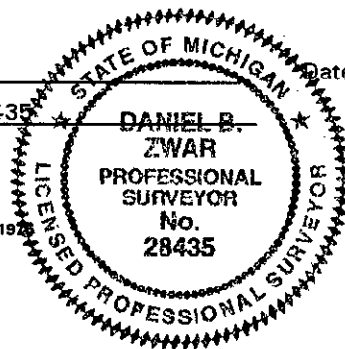

Date Dec 15, 1999

*See pg. 290*

*L. ber 5 Pg. 291*

**WEST QUARTER POST OF SECTION 17,  
TOWN 2 SOUTH, RANGE 14 WEST IN WAVERLY TWP. (C6).  
CONTINUED**

DECEMBER 28 1999

**DEC 28 1999**

**SECTION**

**4/1830 - GOVERNMENT - G. W. Harrison, D.S.**

Ran North between Sections 17 and 18 a distance of 40 chs. (2640.00') and set Quarter Section Post.

**Witnesses:**

12" Sugar - S. 40 Deg. E. - 9 lks. (5.94')

24" Lynn. - N. 38 Deg. W. - 27 lks. (17.82')

