

JAN 17 1996

COMMISSION

Liber 4 Page 302

LAND CORNER RECORDATION CERTIFICATE  
Filing Requirement of Act 74, Mich. P.A. 1970

For corners in Waverly Township

Van Buren County  
(County)

Located In:

Corner Code #

FILED

Nov 14 11 48 AM '95

*Mark A. Smith*  
VAN BUREN CO.  
REGISTERED SURVEYOR

Register of Deeds Stamp & File Number

1. Public Land Survey T 2SR 14W E-1  
 NW Corner, Sect. 4 T R  
 T R  
 T R
2. Property Controlling S T R  
 in Section S T R
3. Miscellaneous S T R  
 Property in Sec. S T R
4. Lot No. \_\_\_\_\_, Recorded Plat \_\_\_\_\_
5. Private Claims \_\_\_\_\_

	A	B	C	D	E	F	G	H	I	J	K	L
2	6	5	4	3	2	1						
3												
4	7	8	9	10	11	12						
5												
6	18	17	16	15	14	13						
7												
8	19	20	21	22	23	24						
9												
10	30	29	28	27	26	25						
11												
12	31	32	33	34	35	36						
13												

I, Donald R. Gilchrist in a field survey on 10/10, 1995, do hereby certify that under requirements of P.A. 74, Michigan P.A. of 1970, the corner points mentioned in lines 1 and 2 above were in conformance with regulations and rules therefore as required in the current manual of survey instructions of the United States Department of the Interior, Bureau of Land Management or by a decree of a Court of Law and/or that the corner points mentioned in lines 3, 4 and 5 above were in conformance with the rules of the Michigan Board of Land Surveyors or by a Decree of a Court of Law; established, re-established, monumented, re-monumented, recovered, found as expressed below:

NOTE: Not more than 4 corners, all in the same town and range, may be recorded on this certificate.

A. Description of original monument and accessories and/or subsequent restoration:

1830-Government -G.W. Harrison, D.S. - North between Sections 4 and 5 a distance of 84.60 chs. (5583.60') to intersection of Town Line at point 75 lks. (49.50') east of corner and set Post Corner. Witness: 30" Beech - South & East - 21 lks. (13.86'). 10" Beech - S. 55° West - 20 lks (13.20'). 10/30/1899 - G. Mutchler, C.S. - Section 4. Stone present. Witness: 5" Tamarack - N37°15' East - 1.00 chs. (66.0'). 7" Apple S32°West - 91 lks. (60.06'). Distance South is 42.095 chs. (2778.27') to Quarter Post, and continuing South 20.145 chs. (1329.57') to Eighth Post, and continuing 20.145 chs. (1329.57') to Section Corner for a total of 5437.41' Continued on Reverse

B. Description of corner evidence found and/or method applied in restoring or reestablishing corner:

Fd. 1/2" iron in monument box - removed iron, dug hole, hit stone - set 20" Slimline Harrison Marker in monument box.


Approved at the March 5, 1995 Van Buren County Peer Group Meeting and is accepted as a careful and faithful re-establishment of the position of the Original Government Corner.

Ratified by Peer Group in  
accordance with P.A. 345 of 1998  
Van Buren County Surveyor

Date 3/5/95 D.R.G.

C. Description of monument for corner and accessories established to perpetuate locating the position of the corner:

Slimline Harrison Marker in monument box  
30" Locus - North 34.70' pk/w in Southeast side  
P.P. - South 70°West - 80.58' pk/w in North side  
Bloomingdale corner - West - 49.42'  
Guy pole - South 5° East - 36.57' pk/w in Northeast side  
Centerline of road East  
Extension of centerline of road - South

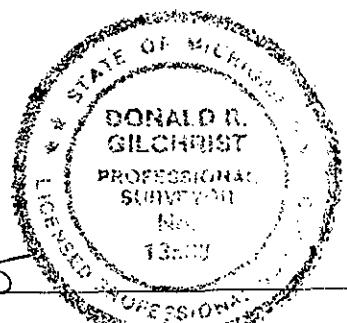

Signed by Donald R. Gilchrist Date 11/14/95

Surveyor's Michigan License No. Donald R. Gilchrist, LIS #13583  
9758 11/14 0105 10SDRVEY 9-00

Continuation

Distance East is 23.7275 chs. (1566.01') and continuing East 16.555 chs. (1092.63') to North Quarter Post for a total of 2658.64'.

1961 - Van Buren County Road Commission -

STA = 108-00

Southwest corner Northeast - 81.2

P.P. - Southwest 81.8

6" Map - NE - 73.5

10/2/1972 - W.O. Smith, C.S. (D. Middleton).

Section 4

Recorded Survey (Liber - Page 25)

Found Monument Box.

**Witness:** 60 Penny Spike in Utility Pole - Southeast - 43.83'

60 Penny Spike in 18" Locust - Northeast - 36.12'

60 Penny Spike in Power Pole - Southwest - 80.30'

Monument box center line West 49.33'.

Distance South of 2778.31' to Quarter Post.

Distance East is 1564.89' and continuing East 1091.35' to Quarter Post for a total of 2656.24'.

10/31/1972 - Don Gilchrist, C.S.

Recordation Certificate (Liber 1 - Page 604).

Found Monument Box

Witness same as W.O. Smith above.