

JAN 17 1996

Libert 4 Page 300  
COMMISSION

LAND CORNER RECORDATION CERTIFICATE  
Filing Requirement of Act 74, Mich. P.A. 1970

For corners in Waverly Township

Van Buren County Located In: Corner Code #

- 1. Public Land Survey T 2SR14W E-3  
     T \_\_\_ R \_\_\_  
     SW Corner, Sec. 4 T \_\_\_ R \_\_\_  
     T \_\_\_ R \_\_\_
- 2. Property Controlling S \_\_\_ T \_\_\_ R \_\_\_  
     in Section S \_\_\_ T \_\_\_ R \_\_\_
- 3. Miscellaneous S \_\_\_ T \_\_\_ R \_\_\_  
     Property in Sec. S \_\_\_ T \_\_\_ R \_\_\_

FILED

Nov 14 11 48 AM '95

*Mark A. Smith*  
VAN BUREN CO.  
REGISTER OF DEEDS

Register of Deeds Stamp & File Number

- 4. Lot No. \_\_\_\_\_, Recorded Plat \_\_\_\_\_
- 5. Private Claims \_\_\_\_\_

A	B	C	D	E	F	G	H	I	J	K	L	N
2	6	5	4	3	2	1						
3												
4	7	8	9	10	11	12						
5												
6	18	17	16	15	14	13						
7												
8	19	20	21	22	23	24						
9												
10	30	29	28	27	26	25						
11												
12	31	32	33	34	35	36						
13												

I, Donald R. Gilchrist survey on 10/10, 1995, do hereby certify that under requirements of P.A. 74, Michigan P.A. of 1970, the corner points mentioned in lines 1 and 2 above were in conformance with regulations and rules therefore as required in the current manual of survey instructions of the United States Department of the Interior, Bureau of Land Management or by a decree of a Court of Law and/or that the corner points mentioned in lines 3, 4 and 5 above were in conformance with the rules of the Michigan Board of Land Surveyors or by a Decree of a Court of Law; established, re-established, monumented, re-monumented, recovered, found as expressed below:

NOTE: Not more than 4 corners, all in the same town and range, may be recorded on this certificate.

- A. Description of original monument and accessories and/or subsequent restoration:  
1830 Government - George W. Harrison, D.S. North between Sections 8 and 9 a distance of 80.00 chs. (5280.00') and set Post Corner. Witness: 15" Beech - South 45° East 17 lks. (11.22'); 20" Beech - North 30° West 13 lks. 8.58' Distance East is 79.55 chs. (5250.30'). Distance West is 80.30 chs. (5299.80'). 6/24/1868 - C.D. Lawton, C.S. Book 2 Page 70 (Section 8). "Found stake and both witnesses (stumps), put down new stake". Distance West to 1/8 Post is 20.105 chs. (1326.93') to stake, continuing West 20.105 chs. (1326.93') to Quarter Post, continuing West 20.105 chs. (1326.93') to stake at Eighth Post, continuing West 20.105 chs. (1326.93') to the Northwest Corner of Section (stone) for a total of 5307.72'. Continued on Reverse.
- B. Description of corner evidence found and/or method applied in restoring or reestablishing corner:

Found iron in monument box - removed. Set 30" Slimline Harrison Marker.

Approved at the July 5, 1995 Van Buren County Peer Group Meeting and is accepted as a careful and faithful re-establishment of the position of the Original Government Corner.

Ratified by Peer Group in accordance with P.A. 345 of 1990  
Van Buren County Surveyor


Date 7/5/95 D. R. G.

- C. Description of monument for corner and accessories established to perpetuate locating the position of the corner:

Slimline Harrison Marker in monument box.  
Stop sign post - South 42° West, 49.05' to North edge.  
Light Pole - North 50° West - 49.46' pk/w in South side.  
Stop sign post - North 80° East - 59.75; North edge.  
P.P. North 40° East - 66.48' pk/w Southwest side.

Signed by Donald R. Gilchrist

Date 11/14/95

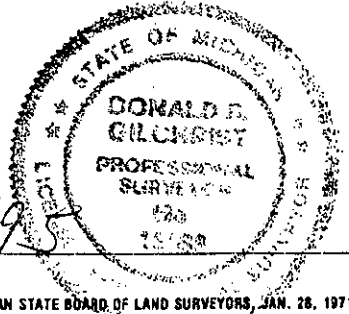

Surveyor's Michigan License No. Donald R. Gilchrist, RLS #13583

**Continuation**

Distance South to Eighth Post (stake) is 20.11 chs. (1327.26') continuing South 20.11 chs. (1327.26') to East Quarter Post (found stake & witnesses) for a total of 2654.52'.

11/2/1899 - G. Mutchler, C.S. Book 6 - Page 2, (Section 4). "Found Stone and Earthen."

**Witness:** 15" Sugar - South 14°20' East, 1.68 chs. (110.88'). Distance East to Eighth Post is 20.185 chs. (1332.21'), continuing East 20.185 chs. (1332.21') to Quarter Post (stone) for a total of 2664.42'. Distance North to Eighth Post (stake) is 20.1425 chs. (1329.40') continuing North to West Quarter Post (file & earthen) 20.1425 chs. (1329.40') for a total of 2658.80'.

1961 - Van Buren County Road Commission Plans

STA 53 + 38

P.P. North 25° East = 90.55'

G. P. North 50° East - 84.5'

15" T-Elm - South 50° West 76.0'

9758 11/15 0125 10SURVEY 9.00