

FILED

NOV 15 1994

VAN BUREN COUNTY REMONUMENTATION  
LAND CORNER RECORDATION CERTIFICATE  
Filing Requirement of Act 74, Mich. P.A. 1970

SEP 21 10 17 AM '94  
Maurice Smith  
VAN BUREN CO.  
REGISTER OF DEEDS

For corners in VAN BUREN COUNTY  
(County)

Located in: SOUTHWEST CORNER SEC. 5, ARLINGTON TOWNSHIP


Corner Code # C-3

1. Public Land Survey	T <u>2</u> S R <u>15</u> W	<u>C-3</u>
	T _____ R _____	_____
	T _____ R _____	_____
	T _____ R _____	_____
2. Property Controlling in Section	S _____ T _____ R _____	_____
	S _____ T _____ R _____	_____
3. Miscellaneous Property in Sec.	S _____ T _____ R _____	_____
	S _____ T _____ R _____	_____

Register of Deeds Stamp & File Number

4. Lot No. \_\_\_\_\_, Recorded Plat \_\_\_\_\_

5. Private Claims \_\_\_\_\_

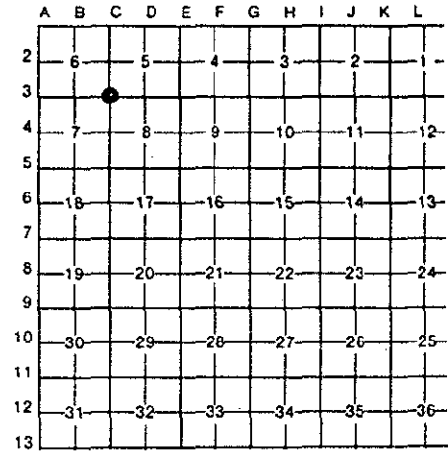

I, George J. Mitchell in a field survey on September 9, 19 94, do hereby certify that under requirements of P.A. 74, Michigan P.A. of 1970, the corner points mentioned in lines 1 and 2 above were in conformance with regulations and rules therefore as required in the current manual of survey instructions of the United States Department of the Interior, Bureau of Land Management or by a decree of a Court of Law and/or that the corner points mentioned in lines 3, 4 and 5 above were in conformance with the rules of the Michigan Board of Land Surveyors or by a Decree of a Court of Law; established, re-established, monumented, re-monumented, recovered, found as expressed below:

NOTE: Not more than 4 corners, all in the same town and range, may be recorded on this certificate.

A. Description of original monument and accessories and/or subsequent restoration:

C-3

Ratified by Peer Group in accordance with P.A. 345 of 1990  
Van Buren County Surveyor

\*SEE BACK OF SHEET\*

Date D.R.G. 9/21/94



B. Description of corner evidence found and/or method applied in restoring or reestablishing corner:

C-3

FOUND 1" HEAVY WALL PIPE AT INTERSECTION OF 28TH AVENUE AND 56TH STREET. VERIFIED CORNER LOCATION FROM RECORDED WITNESSES. SET STANDARD MONUMENT IN MONUMENT BOX

THIS GOVERNMENT MONUMENT WAS RESTORED WITH APPROVAL OF THE VAN BUREN COUNTY REMONUMENTATION PEER GROUP OF SURVEYOR'S, AND IS ACCEPTED AS A CAREFUL AND FAITHFUL PERPETUATION OF THE POSITION OF THE ORIGINAL CORNER.

C. Description of monument for corner and accessories established to perpetuate locating the position of the corner:

C-3

SET STANDARD MONUMENT IN MONUMENT BOX

NAIL & VAN BUREN CO. TAG IN SOUTH SIDE OF GUY POLE	NORTH 72° EAST	62.82'
NAIL & VAN BUREN CO. TAG IN NORTH SIDE OF POWER POLE	SOUTH 73° EAST	57.04'
NAIL & VAN BUREN CO. TAG IN NORTH SIDE OF POWER POLE	SOUTH 83° WEST	144.82'
NAIL & VAN BUREN CO. TAG IN EAST SIDE OF 10" MAPLE	SOUTH 07° WEST	142.79'

Label 4 page 143

Signed by George J. Mitchell  
Surveyor's Michigan License No. 19618

Date September 9, 1994

6457 09/21 0104 105:REVEY 9:00

SOUTHWEST CORNER OF SECTION 5,  
TOWN 2 SOUTH, RANGE 15 WEST, ARLINGTON TOWNSHIP

- 4/1830 - GOVERNMENT - GEORGE HARRISON, D.S.  
RAN NORTH BETWEEN SECTIONS 7 & 8, 80.00 CH., SET POST  
CORNER.  
WITNESSES - 14" BEECH - S 41° E 17 LKS. (11.22')  
9" SUGAR - N 59° W 26 LKS (17.16')
- 11/1865 - A.J. PIERCE, C.S.  
SURVEY RECORDED IN BOOK 3 - PAGE 98. STONE PRE-SET,  
CORROBORATED BY ROOTS OF ONE WITNESS. MEASURED EAST  
39.86 CH. (2630.76') TO SOUTH QUARTER POST OF SECTION 5
- 3/1871 - SURVEY RECORDED BOOK 4 - PAGE 53. STONE PRE-SET  
ALONG WITH SEVERAL SMALL ONES.  
NEW WITNESS - 40" WHITEWOOD N 60° 30' E 78 LKS (51.48')  
MEASURED WEST 20.75 CH. (1320.495') TO 1/8 POST &  
CONTINUED EAST 20.74 CH. (1320.495') TO 1/4 POST.
- 8/17/1934 - T.A. SMITH, C.S.  
DROVE PIPE FROM 1/8 POST & 1/4 POST TO SOUTH IN SEC 7.  
MEASURED WEST 2643.7" TO 1/4 POST.  
MEASURED NORTH 2629' TO 1/4 POST.  
MEASURED SOUTH 1320.2' TO 1/8 POST & CONTINUED 1320.2'  
TO 1/4 POST FOR A TOTAL OF 2640.4'  
ANGLE SOUTH TO WEST 89° 25'
- 7/21/72 - D. A. RATEKIN, R.L.S.  
FOUND 1" PIPE & WITNESSES ON SURVEY RECORDED IN  
(L2-P193). 7/28/1972 - RECORDATION CERTIFICATE (L1-P522)
- 8/14/1972 - GEORGE MITCHELL - R.L.S.  
FOUND 1" PIPE & WITNESS ON SURVEY RECORDED IN (L2-P226).  
9/5/1972 - RECORDATION CERTIFICATE (L1-P536)

*Label # 144*