

FILED

1993

COMMISSION

LAND CORNER RECORDATION CERTIFICATE
Filing Requirement of Act 74, Mich. P.A. 1970

DEC 27 10 00 AM '93

For corners in

Van Buren County
(County)

Located In:

Corner Code #

- 1. Public Land Survey T 2S. R 15W. D 3
N. 1/4 Post Section 8 T _____ R _____
Arlington Township T _____ R _____
T _____ R _____
- 2. Property Controlling S _____ T _____ R _____
in Section S _____ T _____ R _____
- 3. Miscellaneous S _____ T _____ R _____
Property in Sec. S _____ T _____ R _____

Mark A. Smith
VAN BUREN CO.
REGISTER OF DEEDS

Register of Deeds Stamp & File Number

6610 12/27 0105 106SURVEY

- 4. Lot No. _____, Recorded Plat _____
- 5. Private Claims _____

	A	B	C	D	E	F	G	H	I	J	K	L	M
2	6		5		4		3		2		1		
3			●										
4	7		8		9		10		11		12		
5													
6	18		17		16		15		14		13		
7													
8	19		20		21		22		23		24		
9													
10	30		29		28		27		26		25		
11													
12	31		32		33		34		35		36		
13													

I, Daniel B. Rahilly, in a field survey on 12/21/93, 19_____, do hereby certify that under requirements of P.A. 74, Michigan P.A. of 1970, the corner points mentioned in lines 1 and 2 above were in conformance with regulations and rules therefore as required in the current manual of survey instructions of the United States Department of the Interior, Bureau of Land Management or by a decree of a Court of Law and/or that the corner points mentioned in lines 3, 4 and 5 above were in conformance with the rules of the Michigan Board of Land Surveyors or by a Decree of a Court of Law; established, re-established, monumented, re-monumented, recovered, found as expressed below:

NOTE: Not more than 4 corners, all in the same town and range, may be recorded on this certificate.

- A. Description of original monument and accessories, and/or subsequent restoration:
4/30/1830 GOVERNMENT SURVEY - George W. Harrison, D.S.
40.24 1/4 Ch. Set 1/4 Section Post
12" Sugar S. 43 Deg. W. 25 lks.
24" Sugar N. 45 Deg. E. 22 lks.

(A is continued on back of Certificate)


- B. Description of corner evidence found and/or method applied in restoring or reestablishing corner:

Found 1" Pipe
Meas. W. 1325.81 to 1/8 Post - Meas. W. 1325.87 to Sec. Cor.
Meas. E. 2650.91 to Sec. Cor.
Set Harrison Marker in Mon. Box

Approved at 10/27/1993 Van Buren County Peer Group Meeting and is accepted as a careful and faithful reestablishment of the position of the original corner.

- C. Description of monument for corner and accessories established to perpetuate locating the position of the corner:

Harrison Marker in Mon. Box
P.P. S. 60 Deg. W. 31.54' to nail in N. side
USMB Post S. 80 Deg. W. 76.48' to nail in N. side
T.P. N. 70 Deg. W. 110.91' to nail in S. side
20" Apple N. 65 Deg. E. 53.87' to nail in S. side

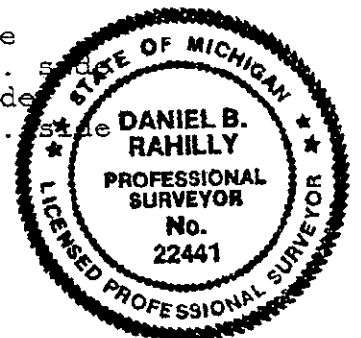

Signed by *Daniel B. Rahilly*

Date 12/21/93

Surveyor's Michigan License No. 22441

- 11/15/1868 - A.J. Pierce, D.C.S.
Stone & Crockery previously set - no wits. rem.
New wits. 8" ? S. 62 Deg. 15' E. 88 lks.
2641.32' East to Sec. Cor.
Bisected line and set stake at 1/8 Post.
- 4/23/1923 - W. H. Goss, C.S.
Stone & Crockery
16" Butter S. 63 Deg. 30' W. 0.87 lks.
12 "Butter N. 32 Deg. 15' E. 0.72 lks.
2653.32' East to Sec. Cor.
- 6/27/1940 - T.A. Smith, C.S.
Stone - Probably dug out by road improvement.
Drove pipe in line with fence N. & S.
Pipe is 1/2" below surface of Black Top.
4" Apple N. 30 Deg. E. 33.0' to Cen. Line
4" Apple N. 55 Deg. E. 53.9' to Cen. Line
SE Corner House N. 15 Deg. W. 70.8'
1325.25' E. to 1/8 Post - 1325.25' E. to Sec. Cor.
- 11/7/1969 - D.A. Ratekin, R.L.S.
Found Pipe
Meas. E. 2650.60' to Sec. Cor.
Meas. W. 2651.93' to Sec. Cor.
- 7/28/1972 - D.A. Ratekin, R.L.S. - Rec'd in (L1-P522)
Found 1" Pipe (GL Road 3' S., Asphalt)
26" Poplar N. 27.5'
38" Poplar N. 55 Deg. W. 46.25'
P.P. S. 50 Deg. W. 31.5'
- 9/5/1972 - G.J. Mitchell, R.L.S. - Rec'd in (L1-P536)
1" Iron Pipe Found
50" Poplar N. 60 Deg. W. 47.55'
24" Poplar North 17.80'
P.P. S. 45 Deg. W. 32.25'