

1993

LAND CORNER RECORDATION CERTIFICATE
Filing Requirement of Act 74, Mich. P.A. 1970

DEC 27 10 00 AM '93

For corners in COMMISSION

Van Buren County (County)

Located In:

Corner Code #

- 1. Public Land Survey Center 1/4 Post Sec. 8 Arlington Township
2. Property Controlling in Section
3. Miscellaneous Property in Sec.

Mark A. Smith
VAN BUREN CO
REGISTER OF DEEDS

Register of Deeds Stamp & File Number

- 4. Lot No.
5. Private Claims

I, Daniel B. Rahilly, in a field survey on 12/21/93, 19, do hereby certify that under requirements of P.A. 74, Michigan P.A. of 1970, the corner points mentioned in lines 1 and 2 above were in conformance with regulations and rules therefore as required in the current manual of survey instructions of the United States Department of the Interior, Bureau of Land Management or by a decree of a Court of Law and/or that the corner points mentioned in lines 3, 4 and 5 above were in conformance with the rules of the Michigan Board of Land Surveyors or by a Decree of a Court of Law; established, re-established, monumented, re-monumented, recovered, found as expressed below:

NOTE: Not more than 4 corners, all in the same town and range, may be recorded on this certificate.

A. Description of original monument and accessories and/or subsequent restoration:

1830 - GOVERNMENT SURVEY - This position was not established by the original government.
11/15/1868 - A.J. Pierce, D.C.S.
Set Stake & Stone at intersection of 1/4 Lines.
3: Walnut - N. 75 Deg. E. - 0.98 lks.
2640.00' to W. 1/4 Post & 2651.55' to E. 1/4 Post.
(A is continued on back of certificate)


B. Description of corner evidence found and/or method applied in restoring or reestablishing corner:

Found 1/2" Iron (Boatspike) in Mon. Box
5.6' N. of CL. of Bituminous Road, 8.09' W. & 1.69' N. of the computed intersection of the 1/4 Lines.
Meas. 2661.12' to E. 1/4 Post - Meas. 2645.43' to S. 1/4 Post
Meas. 2648.63' to W. 1/4 Post - Meas. 2639.42' to N. 1/4 Post

Approved at 10/27/1993 Van Buren County Peer Group Meeting and is accepted as a careful and faithful determination of the position of the corner.

C. Description of monument for corner and accessories established to perpetuate locating the position of the corner:

Boatspike in Mon. Box
Fence Cor. S. 5 Deg. E. 61.3' nail in W. side
P.P. S. 20 Deg. W. 67.6' nail in N. side
T.P. N. 65 Deg. W. 135.7' nail in S. side
USMB Post N. 80 Deg. E. 79.3' nail in S. side
Note: Harrison Marker will be set when weather conditions permit safe survey operations in the roadway. A monument will be recorded after the Harrison Marker is set.

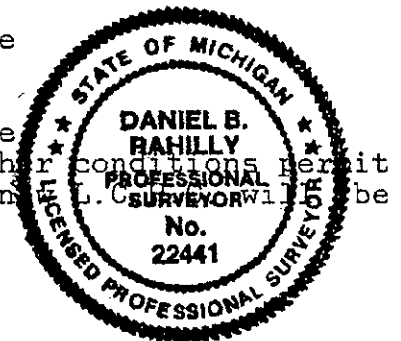

Signed by Daniel B. Rahilly

Date 12/21/93

Surveyor's Michigan License No. 22441

Liber 4 Page 116

- 4/17/1905 - W. H. Goss, C.S.
Found Stone & Pipe
12" Apple - S. 4 Deg. 30' W. - 0.41 lks.
24" Walnut - N. 71 Deg. E. - 0.99 lks.
- 1933 - State Hwy. Survey
Found 1" Pipe 10" below Tarvia
Set 1/2" Iron on top of 1" Pipe
10" Catalpa - N. 14 Deg. 30' E. - 23.60'
Fence Cor. - N. 51 Deg. W. - 41.40'
14" Walnut - N. 64 Deg. W. - 40.05'
- 1939 - State Hwy. Survey
Found 1/2" Pipe
12" Catalpa - N. 24 Deg. E. - 23.55'
16" Apple - S. 1 Deg. E. - 27.83'
16" Walnut - N. 63 Deg. - 40.05'
4.27' N. of 1939 Survey Line
- 6/27/1940 - T.A. Smith, C.S.
Used Corner as taken from State Hwy. Plans, 4.66' N. of CL.
Meas. E. 2654.94' to E. 1/4 Post
- 6/12/1947 - T.A. Smith, C.S.
Meas. 2647.1' to W. 1/4 Post
- 1949 - State Hwy. Plans
Show Corner 4.27' N. of CL.
- 10/4/1957 - W.Q. Smith, C.S.
Note: Showed Mon. Box
- 7/21/72 - D.A. Ratekin, R.L.S.
Broke down the Section, Computed the intersection of the 1/4
Lines. 2657.01' to W. 1/4 Post - 2653.14' to E. 1/4 Post
2641.06' to N. 1/4 Post - 2643.68' to S. 1/4 Post
- 6/27/1980 - D.R. Gilchrist, C.S. - Rec'd in (L3-P23)
Found 1/2" Iron Bar
M.D.S.H. & T. R.O.W. Marker North - 48.00' (South Face)
Phone Pole N.W. - 135.50'
Utility Pole S.W. - 65.75'