

MAY 1 8 1997

DEC 10 8 24 AM '96

LAND CORNER RECORDATION CERTIFICATE
Filing Requirement of Act 74, Mich. P.A. 1970

For corners in Arlington Township

Mark A. Smith
VAN BUREN CO.
REGISTERED SURVEYOR

9.00

374 12/09 0101 10SURVEY

<u>Van Buren County</u> (County)	Located In:	Corner Code #
1. Public Land Survey SW Corner, Sec 10	T 2S R 15W	<u>G-5</u>
	T R	
	T R	
	T R	
2. Property Controlling in Section	S T R	
	S T R	
3. Miscellaneous Property in Sec.	S T R	
	S T R	

Register of Deeds Stamp & File Number

4. Lot No. _____, Recorded Plat _____
5. Private Claims _____

I, Donald R. Gilchrist, in a field survey on October 31, 1996 do hereby state that under requirements of P.A. 74, Michigan P.A. of 1970, the corner points mentioned in lines 1 and 2 above were in conformance with regulations and rules therefore as required in the current manual of survey instructions of the United States Department of the Interior, Bureau of Land Management or by a decree of a Court of Law and /or that the corner points mentioned in lines 3, 4 and 5 above were in conformance with the rules of the Michigan Board of Land Surveyors or by a Decree of a Court of Law, established, re-established, monumented, recovered, found as expressed below:

NOTE: Not more than 2 corners, all in the same town and range, may be recorded on this certificate.

	A	B	C	D	E	F	G	H	I	J	K	L	M
1													
2	6		5		4		3		2		1		
3													
4	7		8		9		10		11		12		
5													
6	10		17		16		15		14		13		
7													
8	19		20		21		22		23		24		
9													
10	30		29		28		27		26		25		
11													
12	31		32		33		34		35		36		
13													

A. Description of original monument and accessories and/or subsequent restoration:

4/18/1830 - GOVERNMENT - George W. Harrison, D.S.

North between Sec 15 & 16 - 80.00 chs set Post Corner.

20" Beech - S 29 Deg W - 37 lks.

12" Beech - N 70 Deg E - 35 lks.

(Continued on back of Certificate)

Validated by Peer Group in
accordance with P.A. 345 of 1990
Van Buren County Surveyor

Date 12/9/96 *D.R.G.*

B. Description of corner evidence found and/or method applied in restoring or reestablishing corner:

8/96 Resetting Mon Box - Found 1/2" pipe down 1'-0.2' S of boat spike.

Set Harrison Marker over 1/2" pipe in Mon Box.

Approved at the 2/24/93 meeting of the Van Buren County Peer Group and is accepted as the best available evidence of the position of the original corner.

C. Description of monument for corner and accessories established to perpetuate locating the position of the corner:

Harrison Marker in Mon Box.

Power Pole - N 26 Deg W - 160.56'.


Power Pole - N 21 Deg W - 151.57'.

W Post on (REH) sign - S 55 Deg E - 176.80'.

Power Pole - S 37 Deg W - 144.10'.

3' S of CL M-43.

3' E of CL 52nd St.

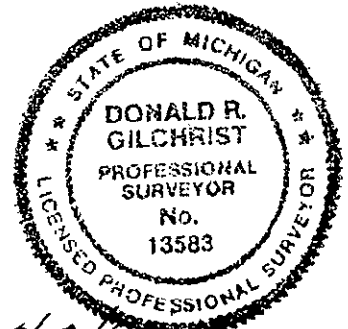

Signed by *Donald R. Gilchrist*
Surveyor's Michigan License No. RLS 13583

Date 12/2/96

11/20/1900 - G. Mutchler, C.S.

Found Stake & Brick.

9" Sugar - N 49 Deg 15' E - 45 lks.

20" Walnut - S 87 Deg W - 47.25 lks.

Meas - North to 1/4 Post - 2639.01'.

Meas - East to 1/4 Post - 2631.42'.

1930+- - T. A. Smith, C.S.

Found Corner.

10" Walnut - S 34 Deg 30' W - 56.42'.

Fence Corner - S 42 Deg E - 41.15'.

12" Walnut - S 69 Deg E - 70.05'.

Meas South to 1/4 Post - 2643.76'.

1949 - State Highway Dept.

Shows Corner 3.44' S of CL.

6/3/50 - Found 3/4" Pipe - 3.44' S of CL Road.

U.S.G.S. B.M. - N 20 Deg W - 64.6'.

Cap in 24" Maple - N 16 Deg E - 81.35'.

Cap in 4" Walnut - S 62 Deg E - 55.11'.

Cap in 12" Walnut - S 35 Deg W - 56.42'.

6/13/55 - W. Q. Smith, C.S.

Used point in Mon Box.

Meas E to 1/4 Post - 2630.26'.

12/2/77 - Used Corner in Mon Box.

1983 - George Mitchell, R.L.S.

Set Corner as per M.S.H.D.

1990 - J.C Hunt, P.S

Used Mon Box.

10/95 D. R. Gilchrist, C.S.

Tie off corner, a Boat Spike in Mon Box for road reconstruction.

LIBER 4 PAGE 376