

FILED

MAY 16 1997

Dec 10 8 24 AM '96

LAND CORNER RECORDATION CERTIFICATE
Filing Requirement of Act 74, Mich. P.A. 1970

For corners in Arlington Township

Van Buren County (County) Located In: _____ Corner Code ## I-5

1. Public Land Survey	T <u>2S</u>	R <u>15W</u>	_____
SW Corner Sec 11	T _____	R _____	_____
	T _____	R _____	_____
	T _____	R _____	_____
2. Property Controlling in Section	S _____	T _____	R _____
	S _____	T _____	R _____
3. Miscellaneous Property in Sec.	S _____	T _____	R _____
	S _____	T _____	R _____

4. Lot No. _____, Recorded Plat _____

5. Private Claims _____

Mark A. Smith
VAN BUREN CO.
REGISTERED CLERK

9-00
12909 0101 10SURVEY
3724

Register of Deeds Stamp & File Number

I, Donald R. Gilchrist, in a field survey on October 31, 19 96, do hereby certify that under requirements of P.A. 74, Michigan P.A. of 1970, the corner points mentioned in lines 1 and 2 above were in conformance with regulations and rules therefore as required in the current manual of survey instructions of the United States Department of the Interior, Bureau of Land Management or by a decree of a Court of Law and/or that the corner points mentioned in lines 3, 4 and 5 above were in conformance with the rules of the Michigan Board of Land Surveyors or by a Decree of a Court of Law; established, re-established, monumented, re-monumented, recovered, found as expressed below:

A	B	C	D	E	F	G	H	I	J	K	L
2	6	5	4	3	2	1					
3											
4	7	8	9	10	11	12					
5											
6	18	17	16	15	14	13					
7											
8	19	20	21	22	23	24					
9											
10	30	29	28	27	26	25					
11											
12	31	32	33	34	35	36					
13											

NOTE: Not more than 4 corners, all in the same town and range, may be recorded on this certificate.


A. Description of original monument and accessories and/or subsequent restoration:
4/30/1830 - GOVERNMENT - George W. Harrison, D.S.
North between Sections 14 & 15 - 80 chs.
Set Post Corner.
5" Blk Ash - S 22 Deg E - 40 lks.
6" Elm - N 60 Deg W - 40 lks.
(Continued on back of Certificate)

B. Description of corner evidence found and/or method applied in restoring or reestablishing corner:
10/95 - Tied off Boat Spike in Mon Box.
8/96 Found Boat Spike OK - Drove down & set Harrison Marker over in raised Mon Box.

Approved at the 3/24/93 meeting of the Van Buren County Peer Group, and is accepted as a careful and faithful perpetuation of the position of the original corner.

Radified by Peer Group in accordance with P.A. 345 of 1990
Van Buren County Surveyor
Date 12/19/96 D.R.G.

C. Description of monument for corner and accessories established to perpetuate locating the position of the corner:
Harrison marker in Mon Box.
P.P. - N 30 Deg E - 91.42'.
P.P. - N 52 Deg W - 122.41'.
P.P. - S 41 Deg W - 89.35'.
M-43 sign - S 71 Deg E - 88.88'.
4' S of CL M-43.

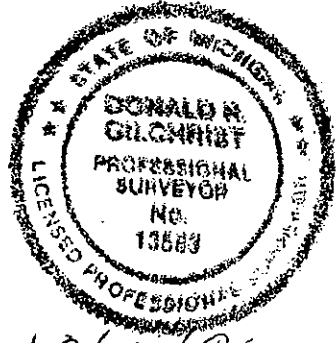

Signed by Donald R. Gilchrist
Surveyor's Michigan License No. RLS 13583

Date 12/2/96

LIBER 4 PAGE 379

12/18/1900 - George Mutchler, C.S.

Book 6 - Stone.

11" Willow - S 65 Deg 15' E - 103.5 lks.

Meas West 19.92 chs (1314.72') to Stone & 19.92 chs (1314.72') to Stone at 1/4 Post. Total 2629.44'.

Meas North 19.898 chs (1313.27') to Stone & 19.898 chs (1313.27') to Stone at 1/4 Post. Total 2626.54'.

5/11/1903 - W. H. Goss, C. S. (See Survey)

Found Stone & Tile.

Meas North 2626.8'.

Meas East 984.06' set iron pipe.

Cont East 328.02' set iron pipe.

Cont East 820.38' set iron pipe.

Cont East 492.36' to Found Stake, Previously set midway. Total 2624.82'.

1939 - M.D.O.T.

Shows Corner 3.74' S of CL.

3/8/60 - W. Q. Smith, C.S.

Found Mon Box.

Meas West to M.B. 2630.75' (Red Book = 2629.44').

Meas North to Found Stake 2628.9' (Red Book = 2626.64').

6/5/80 - Found Boat Spike in Mon Box.

Meas North 1313.94' set 1/8 Post Iron, 1313.94' to 1/4 Post.

1/23/78 - Recorded Liber 2-Page 541.

Total 2627.98'.

10/95 - D. R. Gilchrist, C.S.

Tied off Boat Spike in Mon Box for reconstruction of M-43.

LIBER 4 PAGE 380