

LAND CORNER RECORDATION CERTIFICATE

DEC 17 9 27 AM '98

FILING REQUIREMENT OF ACT 74, MICH. P.A.1970

W 1/4 Post Sec 14 T2S R15W ALINGTON TWP

Mark A. Smith
VAN BUREN CO
REGISTER OF DEEDS

FOR CORNERS OF--:	LOCATED IN--:	CORNER CODE NUMBER
1. PUBLIC LAND SURVEY _____	T. 2 N. S., R. 15 E. W.	I-6
2. PROPERTY CONTROLLING IN SECTION _____	, T. _____ N. S., R. _____ E. W.	_____
3. MISCELLANEOUS PROPERTY IN SECTION _____	, T. _____ N. S., R. _____ E. W.	_____
4. LOT NO. _____, RECORDED PLAT _____		
5. PRIVATE CLAIMS _____		

LIBER 5 PAGE 178

REGISTER OF DEEDS STAMP AND FILING NUMBER

3395 12/17 0101 10SURVEY

I, Charles D. Lossie, do hereby certify that under requirements of P.A. 74, Michigan P.A. of 1970, the corner points mentioned in lines 1 and 2 above were, in a field survey on 12/14, 1998, established, re-established, monumented, re-monumented, recovered or restored as expressed below and in conformance with regulations and rules therefore as required in the current manual of survey instructions of the United States Department of the Interior, Bureau of Land Management or by a decree of a court of law. Furthermore, that the corner points mentioned in lines 3, 4 and 5 above were, in a field survey on _____, 19____, found, recovered, restored, established or re-established as expressed below and in conformance with the rules of the Michigan State Board of Registration for Land Surveyors or, by a Decree of a Court of law:

A. Description of original monument and accessories and/or subsequent restoration:

SURVEY & REMONUMENTATION

JAN 11 1999

SECTION

Ratified by Peer Group in accordance with P.A. 345 of 1998
Van Buren County Surveyor
Date D. R. L. 12-17-98

B. Description of corner evidence found and/or method applied in restoring or re-establishing corner:


Found 3/4" pipe. The found 3/4" pipe was accepted as best available evidence of the position of the original corner at a Peer Group Meeting held on 8/26/98.

C. Description of monument for corner and accessories established to perpetuate locating the position of the corner:

Tied off 3/4" pipe. Set Harrison Marker and monument box.
10" Twin Ash N. 20° W. 109.39' to PK and Washer
36" Maple N 45° E. 52.00' to PK and Washer
Phone Riser Box S. 60° E. 49.77' to centerline of Top
Power Pole S 70° W. 94.44' to PK and Washer

SIGNED BY Charles D. Lossie DATE _____

SURVEYOR'S MICHIGAN REGISTRATION NO. 44291

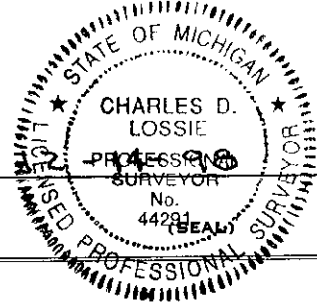

FOR STATE AND UNITED STATES AGENCIES:

SIGNED BY _____ DATE _____
CHIEF OF SURVEY PARTY

APPROVED AND SIGNED BY _____ DATE _____
MICHIGAN REGISTERED LAND SURVEYOR (SEAL)

SURVEYOR'S MICHIGAN REGISTRATION NO. _____

LIBER 5 PAGE 179

**WEST QUARTER POST OF SECTION 14
TOWN 2 SOUTH RANGE 15 WEST, ARLINGTON TOWNSHIP (1-6)**

4/1830 - GOVERNMENT - G. W. Harrison, D.S.

Ran North 40.00 chs. (2640.00') between Sections 14 & 15 and set post corner.

WITNESSES: 16" Beech - N. 84° E. 15 lks. (9.90').
10" Beech - S. 53° W. 22 lks. (14.52').

No Date - Red Book & Goss Notes.

Stone.

WITNESSES: 9" Maple N. 60° E. 45 lks. (29.70').

6/3/1971 - A. W. Howard, R.L.S.

Section 15. Recorded Survey (Liber 1 Page 112).

Shows corner.

WITNESSES: Southwest Corner of House N 45° E 119.5'.
Street Sign S 30° W. 51.2'.
T. P. S 65° W. 94.00'.

Recorded survey (Liber 2 Page 255).

½" pipe - witnesses same as above.

Distance South is 2623.82'.

Distance West is 2621.50'

12/2/1977 - W.Q. Smith, R.L.S.

Section 15. Recorded Survey (Liber 8 page 75).

½" pipe - Witnesses same as above.

Distance North is 2623.96'.

Distance West is 2619.74'.

Recordation Certificate (Liber 2 Page 541).

½" pipe - Witnesses same as above.

3/15/1997 - D. R. Pitts/ Mitchell Surveys Inc.

Section 14. Recorded Survey (Liber 10 Page 335). Found 1" pipe.

WITNESSES: 36" Maple N 40° W. 51.83'.
Power Pole S 48° W. 94.39'.
Twin Elm N.45° W. 59.90'.
R.R. Tie S 45° W. 71.09'.

Distance East is 2628.67'.

**SURVEY &
REMONUMENTATION**

JAN 11 1999

SECTION