

MEMORIAL

FILED

MAY 16 1997

DEC 10 8 24 AM '96

COMMISSION

LAND CORNER RECORDATION CERTIFICATE

Filing Requirement of Act 74, Mich. P.A. 1970

For corners in Arlington Township

Mark A. Smith
VAN BUREN CO.
REGISTER OF DEEDS

9.00
3724 11/09 0101 10SURVEY

Van Buren County (County) Located In: Corner Code #

1. Public Land Survey T 2S R 15W J-5
S 1/4 Post Sec 11 T _____ R _____
T _____ R _____
T _____ R _____

2. Property Controlling S _____ T _____ R _____
in Section S _____ T _____ R _____

3. Miscellaneous S _____ T _____ R _____
Property in Sec. S _____ T _____ R _____

4. Lot No. _____, Recorded Plat _____

5. Private Claims _____

Register of Deeds Stamp & File Number

I, Donald R. Gilchrist, in a field survey on October 31, 19 96, do hereby certify that under requirements of P.A. 74, Michigan P.A. of 1970, the corner points mentioned in lines 1 and 2 above were in conformance with regulations and rules therefore as required in the current manual of survey instructions of the United States Department of the Interior, Bureau of Land Management or by a decree of a Court of Law and/or that the corner points mentioned in lines 3, 4 and 5 above were in conformance with the rules of the Michigan Board of Land Surveyors or by a Decree of a Court of Law; established, re-established, monumented, re-monumented, recovered, found as expressed below.

A	B	C	D	E	F	G	H	I	J	K	L
2	6	5	4	3	2	1					
3											
4	7	8	9	10	11	12					
5											
6	18	17	16	15	14	13					
7											
8	19	20	21	22	23	24					
9											
10	30	29	28	27	26	25					
11											
12	31	32	33	34	35	36					
13											

NOTE: Not more than 4 corners, all in the same town and range, may be recorded on this certificate.

A. Description of original monument and accessories and/or subsequent restoration:
4/20/1830 - GOVERNMENT - George W. Harrison, D.S.
 Set 1/4 Sec Post at 40.00 chs
 30" Elm - N 83 Deg W - 25 lks
 6" Beech - S 75 Deg E - 30 lks.
 (Continued on back of Certificate)

B. Description of corner evidence found and/or method applied in restoring or reestablishing corner:

8/96 Found boat spike under new paving.
 Raised M.B.
 Drove boat spike down.
 Set Harrison Marker over.


Validated by Peer Group in accordance with P.A. 345 of 1990
 Van Buren County Surveyor

Date 12/19/96 D. R. G.

Approved at the 3/24/93 meeting of the Van Buren County Peer Group and is accepted as a careful and faithful **re-establishment** of the position of the original corner.

C. Description of monument for corner and accessories established to perpetuate locating the position of the corner:

Harrison Marker in Mon Box.
 Top CL of end guardrail post - S 14 Deg E - 21.28'.
 12" Elm - S 57 Deg W - 71.72'.
 10" Elm - N 28 Deg E - 58.16'.
 2"-6" Elm - N 54 Deg E - 101.30'.
 4' S of CL M-43.

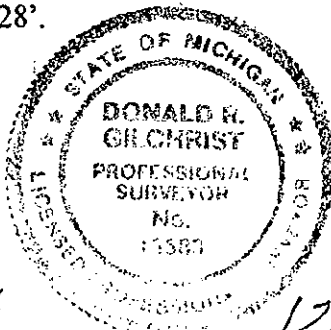

Signed by Donald R. Gilchrist

Date 12/2/96

Surveyor's Michigan License No. RLS 13583

11/09 11 0101 381

5/7/1903 - W. H. Goss, C.S.

Found Stake previously set midway between Section Corners.

Meas West 492.36', set iron pipe and con on 820.38', set iron pipe at 1/8 Post, con on 328.02', set iron pipe and Meas 984.06' to Sec Corner. Total 2624.82'.

Meas East 656.04'. Set Stake, con on 656.04'. Set Stake and Bricks, con on 1312.08' to Sec Corner. Total 2624.16.

6/20/29 - T. A. Smith, C.S.

Meas South from Cen 1/4 Post 2620.2' cut + in Headwall 14.2' North of 1/4 Post. 1/4 Post probably dug out when Bridge was built.

1939 - M.S.H.D. R/W Map

Shows 1/4 Post 4.0' South of CL.

1985 - George Mitchell, R.L.S.

Found Iron in Mon Box 3.74' S of CL M-43 Hwy.

10/1995 - D.R. Gilchrist, C.S.

Found Boat Spike in Mon Box - Tied off for reconstruction of M-43.

LIBER 4 PAGE 382

000
SEARCHED
SERIALIZED
INDEXED