

FILED

LAND CORNER RECORDATION CERTIFICATE  
FILING REQUIREMENT OF ACT 74, MICH. P.A. 1970

Dec 16 9 20 AM '99

S 1/4 Post Sec 14, Arlington Twp.

FOR CORNERS OF:	LOCATED IN:	CORNER CODE NUMBER
1. PUBLIC LAND SURVEY _____	T. <u>2</u> S., R. <u>15</u> W.	<u>J-7</u>
2. PROPERTY CONTROLLING IN SECTION _____	T. _____ S., R. _____ W.	
3. MISCELLANEOUS PROPERTY IN SECTION _____	T. _____ S., R. _____ W.	
4. LOT NO _____	RECORDED PLA _____	
5. PRIVATE CLAIMS _____		

*Mark A. Smith*  
 VAN BUREN CO  
 REGISTER OF DEEDS

SURVEY & REMONUMENTATION

DEC 28 1999

SECTION

REGISTER OF DEEDS STAMP AND FILING NUMBER

I, Charles D. Lossie, in a field survey on 09-Dec, 1999 do hereby state that under requirements of P.A. 74, Michigan P.A. of 1970, the corner points mentioned in lines 1 and 2 above were in conformance with regulations and rules therefore as required in the current manual of survey instructions of the United States Department of the Interior, Bureau of Land Management or by a decree of a Court of Law and/or that the corner points mentioned in lines 3, 4 and 5 above were in conformance with the rules of the Michigan Board of Land Surveyors or by a Decree of a Court of Law; established, re-established, monumented, recovered, found as expressed below:

	A	B	C	D	E	F	G	H	I	J	K	L	M
1													
2	6	5	4	3	2	1							
3													
4	7	8	9	10	11	12							
5													
6	18	17	16	15	14	13							
7													
8	19	20	21	22	23	24							
9													
10	30	29	28	27	26	25							
11													
12	31	32	33	34	35	36							
13													

NOTE: Not More than 2 corners, all in the same town and range may be recorded on this certificate.

A. Description of original monument and accessories and/or subsequent restoration:

**4/1830- GOVERNMENT - G.W. HARRISON, D.S.**

Corrected West between Sections 14 and 23 a distance of 40.095 chs S(2646.27') and set Quarter Section Post.

See Back page for additional History.

B. Description of corner evidence found and/or method applied in restoring or re-establishing corner:

Found 1/2" pipe the position of this Government Monument was accepted and restored with the approval of the Van Buren County Remonumentation Peer Group of Surveyor's on 5/26/99 as the best available evidence of the position of the original corner.

Ratified by Peer Group in accordance with P.A. 345 of 1990  
 Van Buren County Surveyor

Date 12-16-99 D.P.G.


C. Description of monument for corner and accessories established to perpetuate locating the position of the corner:

- Set Harrison Marker at the position of found 1/2" pipe.
- 36" Maple S 10° W., 46.77' to PK and Washer.
- 28" Maple S. 35° E., 51.51' to PK and Washer.
- 8" Maple N. 75° W., 88.47' to PK and Washer.
- 16" Maple N. 65° E., 56.68' to PK and Washer.

Signed by

*Charles D. Lossie*

CHARLES D. LOSSIE, P.S.

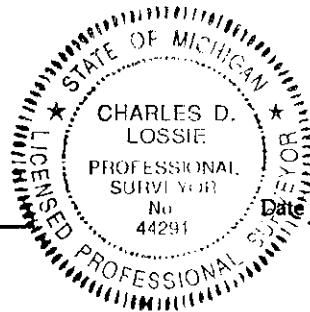

Date 12/14/99

Surveyor's Michigan License No.

44291

FORM APPROVED BY MICHIGAN STATE BOARD OF PROFESSIONAL SURVEYORS,

JAN. 28, 1971

REVISED

MAY. 5, 1975

REVISED

JAN., 1983

REVISED

OCT., 1996

*See 5 pg 284*

*L. Lee 5 Pg. 285*

**S 1/4 Post, Section 14  
T2 S, R15 W., Arlington Twp., (J-7)**

**5/2/1907 - W.H. GOSS, C.S.**

Section 23

Red Book

Set stake- maple clump ( 4 trees) West 3 on split of distance of 39.88 chs. (2632.08')

**3/15/1954 - W.Q. SMITH, C.S.**

Section 23

Red Book

Found iron pipe in line with fence North.

3/15/1957- Drawing shows corner.

Distance East is 316.04' and continuing East 1316.04' for a total of 2632.08'.

Distance South is 2626.00', and continuing South 2626.00' to Center Quarter Post for a total of 5252.00'.

**3/2/1976- A. HOWARD, R.L.S.**

Section 23

Distance East is 1314.55', and continuing East 1314.55' for a total of 2629.10'.

Distance South is 2650.12' to Center Quarter Post.

SURVEY &  
REVISION

**DEC 28 1999**

**SECTION**