

MAY 16 1997

Dec 10 8 24 AM '96

COMMISSION

LAND CORNER RECORDATION CERTIFICATE  
Filing Requirement of Act 74, Mich. P.A. 1970

For corners in Arlington Township

<u>Van Buren County</u> (County)	Located In:	Corner Code #
1. Public Land Survey SW Corner Sec 1	T <u>2S</u> R <u>15W</u>	<u>K-3</u>
	T _____ R _____	_____
	T _____ R _____	_____
	T _____ R _____	_____
2. Property Controlling in Section	S _____ T _____ R _____	_____
	S _____ T _____ R _____	_____
3. Miscellaneous Property in Sec.	S _____ T _____ R _____	_____
	S _____ T _____ R _____	_____

*Mark A. Smith*  
VAN BUREN CO.  
REGISTER OF DEEDS

9.00  
374 12/09 0101 1051RVEY

Register of Deeds Stamp & File Number

4. Lot No. \_\_\_\_\_, Recorded Plat \_\_\_\_\_  
5. Private Claims \_\_\_\_\_

I, Donald R. Gilchrist, in a field survey on October 25, 1996 do hereby state that under requirements of P.A. 74, Michigan P.A. of 1970, the corner points mentioned in lines 1 and 2 above were in conformance with regulations and rules therefore as required in the current manual of survey instructions of the United States Department of the Interior, Bureau of Land Management or by a decree of a Court of Law and/or that the corner points mentioned in lines 3, 4 and 5 above were in conformance with the rules of the Michigan Board of Land Surveyors or by a Decree of a Court of Law; established, re-established, monumented, recovered, found as expressed below:

A	B	C	D	E	F	G	H	I	J	K	L
1											
2	6		5		4		3		2		1
3											
4	7		6		9		10		11		12
5											
6	10		17		16		15		14		13
7											
8	19		20		21		22		23		24
9											
10	30		29		28		27		26		25
11											
12	31		32		33		34		35		36
13											

NOTE: Not more than 2 corners, all in the same town and range, may be recorded on this certificate.

A. Description of original monument and accessories and/or subsequent restoration:

**4/1830 - GOVERNMENT - G. W. Harrison, D.S.**  
Ran North between Sections 11 and 12 a distance of 80.00 chs (5280.00') and set post corner.

**Witnesses:**

12" Beech - N 8 Deg W - 12 lks (7.92').  
7" Beech - S 12 Deg E - 10 lks (6.60').

Distance West is 80.16 chs (5290.56'). Distance East is 79.35 chs (5237.10').  
(Continued on back of Certificate)

B. Description of corner evidence found and/or method applied in restoring or reestablishing corner:

Found 3/4" iron bar in Mon Box - No stone under.


Approved at the 6/25/96 meeting of the Van Buren County Peer Group and is accepted as the best available evidence of the position of the original corner.

Ratified by Peer Group in  
accordance with P.A. 345 of 1990  
Van Buren County Surveyor

Date 12/19/96 D. R. S.

C. Description of monument for corner and accessories established to perpetuate locating the position of the corner:

Set Harrison Marker in place of iron bar.  
Stop sign - N 15 Deg W - 36.80'.  
36" Oak - N 25 Deg E - 97.00' nail W side.  
Tel Ped N 55 Deg E - 44.60' to CL.  
8" Pop - S 25 Deg E - 48.89' to nail W side on CL E&W Road.  
CL Road North is 7' East.

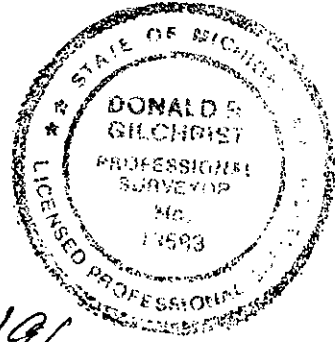

Signed by Donald R. Gilchrist  
Surveyor's Michigan License No. RLS 13583

Date 12/2/96

*LIBER 4 PAGE 405*

**3/28/1887 - County Drain Commission.**

Maloy Drain.

"Commencing 76 Rods South and 1 Rod East of Section Corner."

**5/6/1897 - G. Mutchler, C.S.**

Section 2. Book 5 - Page 63 and Red Book.

Found Corner.

**Witness:**

2" Elm - N 53 Deg E - 64 lks. (42.24').

Ran to Southwest Corner 19.8875 chs (1312.57') to Eighth Post, and continued 1312.57' to Quarter Post, and continued 1312.57' to Eighth Post, and continued 1312.57' to Section Corner for a total of 5250.28'.

1/10/1898 - Book 5 - Page 71 and Red Book. Section 1. Stone.

Distance North is 20.00 chs (1320.00') to Eighth Post (stake), and continuing North 20.00 chs (1320.00') for a total of (2640.00').

Distance East is 19.775 chs (1305.15') to Eighth Post (stake) and continued East 1305.15' to Quarter Post for a total of 2610.30'.

1898 - Survey by application. Section 12. Book 5 - Page 74 and Red Book.

Stone - No witnesses remaining.

Distance East (same as above).

Distance South is 39.79 chs (2626.14').

**5/7/1903 - W. H. Goss, C.S.**

Section 11. Book 1 - Page 152 and Red Book.

Did not visit corner. Field Book.

**Witnesses:**

2" Elm - N 53 Deg E - 64 lks (42.24').

Hickory - S 43 Deg E - 45.5 lks (30.03').

**1/5/1973 - G. J. Mitchell, R.L.S.**

Section 2. Recorded Survey (Liber 3 - Page 200). Found 1" iron bar.

**Witnesses:**

Street Sign - S 45 Deg E - 33.60'.

Power Pole - S 20 Deg W - 67.20'.

Center, Road to North - East - 7.0'.

Distance West is 2623.25' to Quarter Post (Railroad Spike) and continuing 2623.25' to Southwest Corner of Section (Boat Spike) for a total of 5246.50'.

**9/7/1976 - A. McMachen, R.L.S.**

Section 1. Recorded Survey (Liber 7 - Page 68).

Found Corner - witnesses same as above.

Distance East is 1306.75' to Eighth Post and continuing East 1306.75' to Quarter Post for a total of 2613.50'.

Recordation Certificate (Liber 2 - Page 507).

Found Iron - witnesses same as above.

**1/12/1994 - D. R. Gilchrist, C.S.**

Recorded Survey (Liber 10 - Page 78).

Witnesses same as above.

Distance East is 2613.54'. Distance North is 2637.12'.

*LIBER 4 PAGE 406*