

MAY 16 1997

DEC 10 8 24 AM '96

COMMISSIONER

LAND CORNER RECORDATION CERTIFICATE
Filing Requirement of Act 74, Mich. P.A. 1970

Mark A. Smith
VAN BUREN CO.
REGISTER OF DEEDS

9.00
12/09 0101 10SURVEY

For corners in Arlington Township

| | | |
|-------------------------------------|--------------------------|---------------|
| <u>Van Buren County</u> (County) | Located In: | Corner Code # |
| 1. Public Land Survey | T <u>2S</u> R <u>15W</u> | <u>K-5</u> |
| SW Corner Sec 12 | T _____ R _____ | _____ |
| | T _____ R _____ | _____ |
| | T _____ R _____ | _____ |
| 2. Property Controlling in Section | S _____ T _____ R _____ | _____ |
| | S _____ T _____ R _____ | _____ |
| 3. Miscellaneous Property in Sec. | S _____ T _____ R _____ | _____ |
| | S _____ T _____ R _____ | _____ |

Register of Deeds Stamp & File Number

4. Lot No. _____, Recorded Plat _____
5. Private Claims _____

I, Donald R. Gilchrist, in a field survey on October 31, 1996 do hereby state that under requirements of P.A. 74, Michigan P.A. of 1970, the corner points mentioned in lines 1 and 2 above were in conformance with regulations and rules therefore as required in the current manual of survey instructions of the United States Department of the Interior, Bureau of Land Management or by a decree of a Court of Law and/or that the corner points mentioned in lines 3, 4 and 5 above were in conformance with the rules of the Michigan Board of Land Surveyors or by a Decree of a Court of Law, established, re-established, monumented, recovered, found as expressed below:

NOTE: Not more than 2 corners, all in the same town and range, may be recorded on this certificate.

| | | | | | | | | | | | | |
|----|---|----|---|----|---|----|---|----|---|----|---|----|
| 1 | A | B | C | D | E | F | G | H | I | J | K | L |
| 2 | | 6 | | 5 | | 4 | | 3 | | 2 | | 1 |
| 3 | | | | | | | | | | | | |
| 4 | | 7 | | 8 | | 9 | | 10 | | 11 | | 12 |
| 5 | | | | | | | | | | | | |
| 6 | | 18 | | 17 | | 16 | | 15 | | 14 | | 13 |
| 7 | | | | | | | | | | | | |
| 8 | | 19 | | 20 | | 21 | | 22 | | 23 | | 24 |
| 9 | | | | | | | | | | | | |
| 10 | | 30 | | 29 | | 28 | | 27 | | 26 | | 25 |
| 11 | | | | | | | | | | | | |
| 12 | | 31 | | 32 | | 33 | | 34 | | 35 | | 36 |
| 13 | | | | | | | | | | | | |

A. Description of original monument and accessories and/or subsequent restoration:

4/1830 - GOVERNMENT - George W. Harrison, D.S.

Ran North between Sections 13 & 14 a distance of 80.00 chs (5280.00') & set Post Corner.

Witnesses:

12" Tamarack - N 81 Deg W - 14 lks (9.24').

7" Tamarack - N 76 Deg 30' E - 30 lks (19.80').

(Continued on back of Certificate)

B. Description of corner evidence found and/or method applied in restoring or reestablishing corner:

10/96 - Found Iron in Mon Box - Raised Mon Box.

Set Harrison Marker over Iron.

Approved at the ^{12/19/96 SPECIAL P.R.G.} ~~17/4/96~~ meeting of the Van Buren County Peer Group, and is accepted as a careful and faithful **re-establishment** of the position of the original corner.

Ratified by Peer Group in accordance with P.A. 345 of 1996
Van Buren County Surveyor

Date 12/19/96 *S.P.G.*

C. Description of monument for corner and accessories established to perpetuate locating the position of the corner:

Harrison Marker in Mon Box.

45" Pop - N 123.92' to nail & tag in East side.


66" Pop - S 21 Deg E - 101.62' nail & tag in West side.

48" Pop - S 80 Deg W - 189.90' nail & tag in North side.

Notch in Headwall - S 8.18'.

CL Drain - 12' W.

CL M-43 - N - 19.6'.

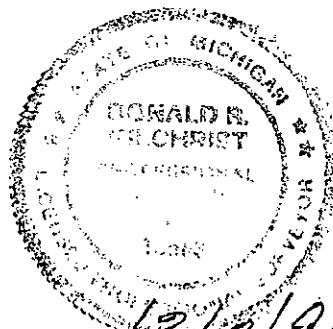

Signed by *Donald R. Gilchrist*
Surveyor's Michigan License No. RLS 13583

Date 12/2/96

4/1898 - G. Mutchler, C.S.

Book 5 - Page 74.

Found Stake - No witnesses remaining.

Witness - SE Pillar of Bridge - S 66 Deg 45' W - 20 lks (13.20').

Measured North 39.68 chs (2618.88').

Measured East 19.725 chs (1301.85') to 1/8 Post & continued 19.725 chs (1301.85') to 1/4 Post for a total of 2603.70'.

5/6/1903 - W. H. Goss, C.S.

Book 1 - Page 152.

Found Stones & Stakes.

Measured North 19.82 chs (1308.12') to 1/8 Post (Tamarack Stake) & continued North to 1/4 Post 19.82 chs (1308.12') for a total of 2616.24'. Found 1/4 Post, a Tamarack Stake in bottom of ditch under the bridge.

Measured West 19.88 chs (1312.08') to 1/8 Post (Stake & Brick) and continued on to South 1/4 Post (found Stake) 19.88 chs (1312.08') for a total of 2624.16'.

4/1942 - M.D.O.T.

R/W Book.

Shows Corner to be 19.48' South of CL of Hwy & 20' +/- East of CL of bridge.

Measured West 2617' +/- to 1/4 Post.

Measured East 2607.58'.

4/12/1980 - D. R. Gilchrist, C.S.

County Drain notes.

Set corner at Prorate of Hwy plans.

Measured West to 1/4 Post (2616.11').

See copies of Comp. notes & drawings.

6/9/95 - J. C. Hunt, P.S.

SW Cor Sec 12: Evidence found: None. Set 1/2" Iron Rod from M.D.O.T. records & G. Mitchell, P.S. records. Corner is 19.5' S CL M-43 Hwy & 12' E CL drainage ditch North & South. North 2618.70' is W 1/4 Post of Section 12 T2S-R15W; North 5237.40' is NW corner of Sec 12 T2S-R15W; N 89 Deg 49'20" E 2608.23' is S 1/4 Post of Sec 12 T2S-R15W; S 89 Deg 57'50" W 2616.68' is S 1/4 Post of Sec 11 T2S-R15 W.

1/2" Iron Rod. N 0 Deg 20' W 123.95' Set nail & tag E face 32" Elm. S 30 Deg E 9.40' NE cor conc headwall. S 33 Deg W 129.65'. Set nail & tag E face pole. S 28 Deg W 9.70' Set nail & tag top of wood post for guardrail. S 78 Deg W 42.84' Set nail & tag in top of wood post for guardrail.

10/18/95 - D R. Gilchrist, C.S.

FD Iron in Mon Box.

8' N of S Bridge Wall.

Digt East = 2608.29'.

LIBER 4 PAGE 386