

SURVEY'S  
REMOVAL

FILED

**LAND CORNER RECORDATION CERTIFICATE**

FILING REQUIREMENT OF ACT 74, MICH. P.A. 1970

Dec 16 9 20 AM '99

*Mark A. Smith*  
VAN BUREN CO.  
REGISTER OF DEEDS

W 1/4 Post Sec 24 Arlington Twp

FOR CORNERS OF:	LOCATED IN:	CORNER CODE NUMBER
1. PUBLIC LAND SURVEY _____, T. <u>2</u> S., R. <u>15</u> W.	(X) _____	<u>K-8</u>
2. PROPERTY CONTROLLING IN SECTION _____, T. _____ S., R. _____ W.	N. _____ E. _____	
3. MISCELLANEOUS PROPERTY IN SECTION _____, T. _____ S., R. _____ W.	N. _____ E. _____	
4. LOT NO _____, RECORDED PLA _____		
5. PRIVATE CLAIMS _____		

REGISTER OF DEEDS STAMP  
AND FILING NUMBER

I, Charles D. Lossie, in a field survey on 09-Dec, 1999 do hereby state that under requirements of P.A. 74, Michigan P.A. of 1970, the corner points mentioned in lines 1 and 2 above were in conformance with regulations and rules therefore as required in the current manual of survey instructions of the United States Department of the Interior, Bureau of Land Management or by a decree of a Court of Law and/or that the corner points mentioned in lines 3, 4 and 5 above were in conformance with the rules of the Michigan Board of Land Surveyors or by a Decree of a Court of Law; established, re-established, monumented, recovered, found as expressed below:

	A	B	C	D	E	F	G	H	I	J	K	L	M
1													
2	6		5		4		3		2		1		
3													
4	7		8		9		10		11		12		
5													
6	18		17		16		15		14		13		
7													
8	19		20		21		22		23		24		
9													
10	30		29		28		27		26		25		
11													
12	31		32		33		34		35		36		
13													

NOTE: Not More than 2 corners, all in the same town and range may be recorded on this certificate.

A. Description of original monument and accessories and/or subsequent restoration:

4/1830 - GOVERNMENT - G.W. HARRISON, D.S.  
Ran North between Section 23 and 24 a distance of 40.00 chs. (2640.00') and set Quarter Section Post.  
Witnesses: 17" Lynn - N. 66° E., 23 lks (15.18').  
6" Beech S. 59° W., 22 lks (14.52').

See back page for additional History.

B. Description of corner evidence found and/or method applied in restoring or re-establishing corner:

Found 3/4" pipe from old W.Q. Smith witnesses. The position of this Government Monument was accepted and restored with the approval of the Van Buren County Remonumentation Peer Group of Surveyor's on 5/26/99 as best available evidence of the position of the original corners.


Ratified by Peer Group in  
accordance with P.A. 345 of 1990  
Van Buren County Surveyor

Date 12-16-99 D.P.A.

C. Description of monument for corner and accessories established to perpetuate locating the position of the corner:

Set Harrison Marker at the position of the 3/4" pipe.  
38" Maple, n. 45° W., 42.73' to PK and Washer.  
8" Maple, N. 30° E., 46.55' to PK and Washer.  
18" Maple, S. 40° E., 67.06' to PK and Washer.  
4" maple, S. 45° W., 84.42' to PK and Washer.

Signed by Charles D. Lossie  
CHARLES D. LOSSIE, P.S.

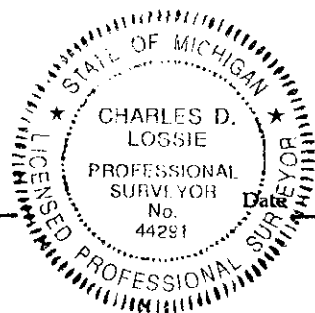

Date 12/14/99

Surveyor's Michigan License No. 44291

*L. Lee 5 pg 282*

Liber 5 Pg 283

**West 1/4 Post, Sec 24  
Arlington Twp. (K-8)**

**5/2/1907 - W. H. GOSS, C.S.**

Section 23  
Red Book  
Found stones  
Distance West is 39.41 chs (2601.06').

**3/15/1954 - W.Q. SMITH, C.S.**

Section 23  
Red Book  
Found spike - drove 3/4" iron pipe.

**Witnesses:**

36" Maple - S. 60° E., 71.6' to Centerline.  
18" Maple - N. 45° W., 43.5' to Centerline.  
12" Maple - N. 70° E., 83.00' to Centerline.

3/20/1954 - Drawing shows corner.

Distance West is 1296.5' and continuing West 1296.50' to Center Quarter Post for a total of 2593.00'.

Distance South is 1307.25', and continuing 1307.25' to Southwest Corner.

**3/2/1976- A. HOWARD, R.L.S.**

Section 23  
Survey Drawing  
Distance West is 2598.20'.  
Distance North is 2626.00'.

Note: Set 1" iron pipe at intersection of Quarter Lines for Center of Section.  
Found new 1" iron pipe 4' East.

SURVEY &  
RECORDS

1900

SECTION