

FILED

LAND CORNER RECORDATION CERTIFICATE
FILING REQUIREMENT OF ACT 74, MICH. P.A. 1970

Dec 16 9 20 AM '99

SW Corner, Sec 24, Arlington Twp.

FOR CORNERS OF:	LOCATED IN:	CORNER CODE NUMBER
1. PUBLIC LAND SURVEY _____, T. <u>2</u> S., R. <u>15</u> W.	X S., R.	<u>K-9</u>
2. PROPERTY CONTROLLING IN SECTION _____, T. _____ S., R. _____ W.	N. S., R.	
3. MISCELLANEOUS PROPERTY IN SECTION _____, T. _____ S., R. _____ W.	N. S., R.	
4. LOT NO _____, RECORDED PLA _____		
5. PRIVATE CLAIMS _____		

Mark A. Smith
VAN BUREN CO.
REGISTER OF DEEDS

SURVEY &
REGISTER OF DEEDS STAMP
AND FILING NUMBER

I, Charles D. Lossie, in a field survey on 13-Dec, 1999 do hereby state that under requirements of P.A. 74, Michigan P.A. of 1970, the corner points mentioned in lines 1 and 2 above were in conformance with regulations and rules therefore as required in the current manual of survey instructions of the United States Department of the Interior, Bureau of Land Management or by a decree of a Court of Law and/or that the corner points mentioned in lines 3, 4 and 5 above were in conformance with the rules of the Michigan Board of Land Surveyors or by a Decree of a Court of Law; established, re-established, monumented, recovered, found as expressed below:

	A	B	C	D	E	F	G	H	I	J	K	L	M
1													
2	6	5	4	3	2	1							
3													
4	7	8	9	10	11	12							
5													
6	18	17	16	15	14	13							
7													
8	19	20	21	22	23	24							
9													
10	30	29	28	27	26	25							
11													
12	31	32	33	34	35	36							
13													

NOTE: Not More than 2 corners, all in the same town and range may be recorded on this certificate.

A. Description of original monument and accessories and/or subsequent restoration:

4/1830 - GOVERNMENT - G.W. HARRISON, D.S.
Ran North between Sections 25 and 26 a distance of 80.00 chs. (5280.00') and set Section Post.
Witnesses: 16" Lynn. S. 60° E., 50 lks. (33.00').
24" Lynn. N. 73° W., 18 lks. (11.88').
Distance West is 79.53 chs (5248.985'). 1/2 = 2624.49'.
Distance East is 80.00 chs (5299.80'). 1/2 = 2649.9'.
See back page for additional History

B. Description of corner evidence found and/or method applied in restoring or re-establishing corner:

Found 1" pipe set over 1/2" pipe down 24" from old witnesses by W.H. Goss, C.S. in 6/3/1905. The position of this Government Monument was accepted and restored with the approval of the Van Buren County Remonumentation Peer Group of Surveyor's meeting held on 5/26/99 as the best available evidence of the position of the original corner.


Ratified by Peer Group in
accordance with P.A. 345 of 1990
Van Buren County Surveyor

Date 12-16-99 D.R.A.

C. Description of monument for corner and accessories established to perpetuate locating the position of the corner:

Tied off 1" pipe. Set Harrison Marker.
N.E. Corner Church foundation, S. 58° W., 98.00'.
N.W. Corner House foundation, S. 15° E., 197.12'.
Power Pole - N. 40° W., 98.43' to PK and Washer
Power Pole - N. 25° E., 86.86' to PK and Washer.

Signed by Charles D. Lossie
CHARLES D. LOSSIE, P.S.

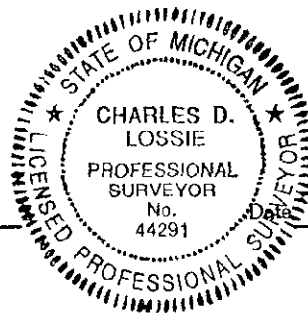

12/15/99

Surveyor's Michigan License No. 44291

L. Dec 5 Pg. 278

FORM APPROVED BY MICHIGAN STATE BOARD OF PROFESSIONAL SURVEYORS, JAN. 28, 1971
REVISED MAY. 5, 1975
REVISED JAN., 1983
REVISED OCT., 1996

Liber 5 pg 279

**Southwest Corner, Section 24
Town 2 South, Range 15 West, Arlington Twp., (K-9)**

1/3/1868 - C.D. LAWTON, C.S.

Section 26

Book 2 - Page 49 & Red book

Found Corner, measured West 79.19 chs. (5226.54') and set Quarter Post midway at 2613.27'.

5/27/1869 - A.J. PIERCE, D.C.S.

Book 3 - Page 27 and Red Book.

Found all Government in good condition.

6/3/1905 - W.H. GOSS, C.S.

Section 26

Book 1 - Page 172 & Red Book.

Found stone.

Witnesses:

Northwest corner schoolhouse - S. 15° E., 299 lks. (197.34').

Northwest corner church - S. 58° W., 148.5 lks. (98.01').

Distance West is 39.07 chs. (2578.62') and continuing West 40.10 chs. (2646.60') to Northwest corner for a total of 5225.22'.

Note: Distance South is 39.79 chs. (2626.14').

3/20/1954 - W.Q. SMITH, C.S.

Section 23

Drawing shows corner.

Distance North is 1307.25' and continuing North 1307.25' to Quarter Post for a total of 2614.50'.

Distance West is 1288.60' and continuing West 1288.60' to Quarter Post for a total of 2577.20'.

3/13/1975 - W.Q. SMITH, R.L.S./ P.COULSON, P.C.

Section 27

Note: Looks like they set corner.

Distance East is 2636.80' to fence - center line road East.

Distance South is 1303.60', and continuing South 1347.02'.

4/7/1978 - GOVE/ W.Q. SMITH.

Section 27

Note: Found Corner.

SURVEY &
RECORDS

003