

NOV 15 1994

LAND CORNER RECORDATION CERTIFICATE
Filing Requirement of Act 74, Mich. P.A. 1970

OCT 18 12 03 PM '94

LIBER 4 PAGE 110
COMMISSION
For corners in Arlington Township

Mark A Smith
VAN BUREN CO.
REGISTER OF DEEDS

9.00
7341 10/18 0101 10SURVEY

Van Buren County (County)	Located In:	Corner Code ##
1. Public Land Survey NE Cor Sec 35	T 2 SR15 W T ___ R ___ T ___ R ___ T ___ R ___	K-11 _____ _____ _____
2. Property Controlling in Section	S ___ T ___ R ___ S ___ T ___ R ___	_____ _____
3. Miscellaneous Property of <u>Donald R. Gilchrist</u>	S ___ T ___ R ___ T ___ R ___	_____ _____
4. Lot No. _____, Recorded Plat _____		
5. Private Claims _____		

Register of Deeds Stamp & File Number

I, Donald R. Gilchrist, in a field survey on _____, 19_____, do hereby certify that under requirements of P.A. 74, Michigan P.A. of 1970, the corner points mentioned in lines 1 and 2 above were in conformance with regulations and rules therefore as required in the current manual of survey instructions of the United States Department of the Interior, Bureau of Land Management or by a decree of a Court of Law and/or that the corner points mentioned in lines 3, 4 and 5 above were in conformance with the rules of the Michigan Board of Land Surveyors or by a Decree of a Court of Law; established, re-established, monumented, re-monumented, recovered, found as expressed below:

NOTE: Not more than 4 corners, all in the same town and range, may be recorded on this certificate.

A. Description of original monument and accessories and/or subsequent restoration:

- Feb 8, 1830 - Government - G.W. Harrison, D.S., set Post, 14" Beech - S 45° E - 8 lks; 24" Beech - N 12½° W - 31 lks.
- May 5, 1866 - C.J. Monroe, Co. Survey (B1-46), Sec 35, set stake & 3 stones at all US Post
- May 14, 1868 - A.J. Pierce (3-14&15), found stone
- May 26, 1869 - A.J. Pierce (3-77), stone pre set; 8" Sug - S 64½° W - 1.28 ch.
- October 5, 1908 - W.H. Goss, Co. Surveyor, set 1" pipe.

(Continued on back of Certificate)

B. Description of corner evidence found and/or method applied in restoring or reestablishing corner:

12/10/92 G. Mitchell found pipe per above witnesses. Removed pipe and set standard cast iron monument. Corner was approved at County Peer Group Meeting on 10/25/92 (Recorded L 3, P 264). Corner was field checked on 9/26/94 by D.R. Gilchrist, Co. Surveyor. Approved at the 10/5/94 Van Buren County Peer Group Meeting and is accepted as a careful and faithful re-establishment of the position of the Original Government Corner.

Ratified by Peer Group in accordance with P.A. 345 of 1990
Van Buren County Surveyor

Date D.R.G. 10/18/94


C. Description of monument for corner and accessories established to perpetuate locating the position of the corner:

- Standard Monument - Harrison Marker
- Nail in 28" Maple - S 45° E 67.59'
- Nail in 30" Maple - N 70° E 99.21'
- Nail in P. Pole - N 50° E 54.12'
- Nail in 6" Pine - N 05° W 91.57'
- 12'± W of CL N&S Rd
- On CL of E&W Rd

Signed by Donald R. Gilchrist Date 10/13/94

Surveyor's Michigan License No. Donald R. Gilchrist, RLS #13583

A	B	C	D	E	F	G	H	I	J	K	L	M
2	6	5	4	3	2	1						
3												
4	7	8	9	10	11	12						
5												
6	18	17	16	15	14	13						
7												
8	19	20	21	22	23	24						
9												
10	30	29	28	27	26	25						
11												
12	31	32	33	34	35	36						
13												

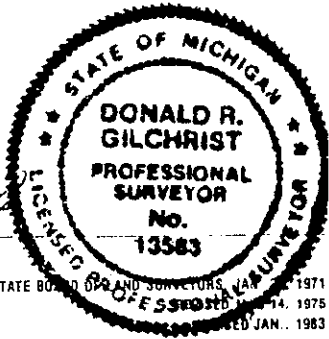



LABEL 4 PAGE 162

Continued from front of Certificate

A. June 20, 1945 - T. A. Smith, Co Surveyor

Found pipe

5' S of Cen Line of E&W Rd.

12' W of Cen Line N&S Rd.

12" Maple - S 60 Deg E - 67.9' to Cen Line.

20" Maple - N 65 Deg E - 99.6' to Cen Line.

May 8, 1972 - W. Q. Smith, Co Surveyor (Survey Rec'd L2-P1)
Rec'd Corner (L1-P408)

1978 & 1981 J. C. Hunt
Found corner as Rec'd.