

FILED

NOV 15 1994

LIBER 4 RECORDS

LAND CORNER RECORDATION CERTIFICATE
Filing Requirement of Act 74, Mich. P.A. 1970

OCT 18 12 0 PM '94

For corners in Arlington Township

Van Buren County
(County)

Located In:

Corner Code #

Mark A. Smith
VAN BUREN CO
REGISTERED SURVEYOR

9.00

- 1. Public Land Survey T 2 S R 15 W K-12
E~~X~~ Post Sec 35
- 2. Property Controlling in Section S ___ T ___ R ___
- 3. Miscellaneous Property in Sec. S ___ T ___ R ___

Register of Deeds Stamp & File Number

7461 10/13 0101 10SURVEY

- 4. Lot No. _____, Recorded Plat _____
- 5. Private Claims _____

	A	B	C	D	E	F	G	H	I	J	K	L	M
2	6	5	4	3	2	1							
3													
4	7	8	9	10	11	12							
5													
6	18	17	16	15	14	13							
7													
8	19	20	21	22	23	24							
9													
10	30	29	28	27	26	25							
11													
12	31	32	33	34	35	36							
13													

I, Donald R. Gilchrist, in a field survey on _____, 19____, do hereby certify that under requirements of P.A. 74, Michigan P.A. of 1970, the corner points mentioned in lines 1 and 2 above were in conformance with regulations and rules therefore as required in the current manual of survey instructions of the United States Department of the Interior, Bureau of Land Management or by a decree of a Court of Law and/or that the corner points mentioned in lines 3, 4 and 5 above were in conformance with the rules of the Michigan Board of Land Surveyors or by a Decree of a Court of Law; established, re-established, monumented, re-monumented, recovered, found as expressed below:

NOTE: Not more than 4 corners, all in the same town and range, may be recorded on this certificate.

A. Description of original monument and accessories and/or subsequent restoration:

Feb 8, 1830 - Government - G.W. Harrison, D.S., .50 stream 6 lks wide, course SE; 10.60 stream 4 lks wide, course SE; 20.93 lks 6" Sugar; 26.00 stream 3 lks wide, course SE; 40.00 set 1/4 Sec Post; 17" Sugar - S 52° E - 6 lks; 14" Sugar - N 51° W - 44 lks.
 May 5, 1866 - C.J. Monroe, Co. Surveyor - set stake & 3 stones
 April 29, 1890 - EP Waterman, Sur., Allegan, Mich. - plow point, stones & earthenware

(continued on back of Certificate)

B. Description of corner evidence found and/or method applied in restoring or reestablishing corner:

12/10/92 G. Mitchell found pipe per above witnesses. Removed pipe and set standard cast iron monument. Corner was approved at County Peer Group Meeting on 10/25/92 (Recorded L 3, P 264).
 Corner was field checked on 9/26/94 by D.R. Gilchrist, Co. Surveyor. Approved at the 10/5/94 Van Buren County Peer Group Meeting and is accepted as a careful and faithful re-establishment of the position of the Original Government Corner.


Ratified by Peer Group in accordance with P.A. 345 of 1990
 Van Buren County Surveyor


Date D. R. G. 10/16/94

C. Description of monument for corner and accessories established to perpetuate locating the position of the corner:

Standard Monument - Harrison Marker
 Nail in 28" Maple - N 06° E 232.23'
 Top centerline South end
 48" CMP N 10° W 203.12'
 PK nail in blacktop S 01° E 50.00'
 PK Nail in blacktop N 03° W 50.00'
 On CL N&S Rd

Signed by Donald R. Gilchrist Date 10/3/94
 Surveyor's Michigan License No. Donald R. Gilchrist, RLS #13583

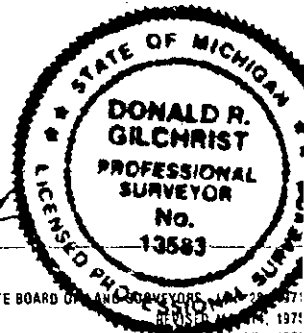

 

LIBER 4 PAGE 164

Continued from front of Certificate

A. Oct. 5, 1908 - W. H. Goss, Co Surveyor
Stones & Iron
7" Elm - NE - 4 lks
6" Elm - NW - 56 lks

June 20, 1945 - T. A. Smith, Co Surveyor
Set pipe over Plow Point

May 18, 1972 - W. Q. Smith, Co Surveyor
Corner rec'd (L1-P408)