

MAY 1 5 1997

Dec 10 8 24 AM '96

COMMISSION

LAND CORNER RECORDATION CERTIFICATE
Filing Requirement of Act 74, Mich. P.A. 1970

Mark A. Smith
VAN BUREN CO.
REGISTERED PROFESSIONAL SURVEYOR

9-00

For corners in Arlington Township

<u>Van Buren County</u> (County)	Located In:	Corner Code #
1. Public Land Survey S 1/4 Post Sec 12	T <u>2S</u> R <u>15W</u>	<u>L-5</u>
	T _____ R _____	_____
	T _____ R _____	_____
	T _____ R _____	_____
2. Property Controlling in Section	S _____ T _____ R _____	_____
	S _____ T _____ R _____	_____
3. Miscellaneous Property in Sec.	S _____ T _____ R _____	_____
	S _____ T _____ R _____	_____

Register of Deeds Stamp & File Number

12/09 0101 10SURVEY

4. Lot No. _____, Recorded Plat _____
5. Private Claims _____

I, Donald R. Gilchrist, in a field survey on November 17, 1996 do hereby state that under requirements of P.A. 74, Michigan P.A. of 1970, the corner points mentioned in lines 1 and 2 above were in conformance with regulations and rules therefore as required in the current manual of survey instructions of the United States Department of the Interior, Bureau of Land Management or by a decree of a Court of Law and/or that the corner points mentioned in lines 3, 4 and 5 above were in conformance with the rules of the Michigan Board of Land Surveyors or by a Decree of a Court of Law; established, re-established, monumented, recovered, found as expressed below:

A	B	C	D	E	F	G	H	I	J	K	L
1											
2	6		5		4		3		2		1
3											
4	7		8		9		10		11		12
5											
6	10		17		16		15		14		13
7											
8	19		20		21		22		23		24
9											
10	30		29		28		27		26		25
11											
12	31		32		33		34		35		36
13											

NOTE: Not more than 2 corners, all in the same town and range, may be recorded on this certificate.

A. Description of original monument and accessories and/or subsequent restoration:
4/1830 - GOVERNMENT - W. G. Harrison, D.S.
Set Quarter Section Post at 40.00 chs (2640.00').

Witnesses:

- 8" Beech - S 35 Deg W - 16 lks (10.56')
- 14" Beech - N 33 Deg E - 29 lks (19.14')

(Continued on back of Certificate)

B. Description of corner evidence found and/or method applied in restoring or reestablishing corner:

Found 1/2" Iron - 27.78' S of CL M-43 and on Fence Line - S.
Distance measured East is 2627.65'.
Distance measured West is 2608.29'.
Dug for stone 1' East - Found nothing.


Ratified by Peer Group in accordance with P.A. 345 of 1990
Van Buren County Surveyor

Date 12/19/96 D.R.A.

Approved at the 10/25/95 meeting of the Van Buren County Peer Group and is accepted as the best available evidence of the position of the original corner.

C. Description of monument for corner and accessories established to perpetuate locating the position of the corner.

Set Harrison Marker in Mon Box over iron.
50" Wal - S 60 Deg E 51.80' to N & W in N side.
15" Mul - S 6 Deg E - 29.46' to N & W in E side.
Fence Line - S - 25'+-.
16" Wal - N 47 Deg W - 107.12' to N & W in SW side.
Power Pole - N 47 Deg E - 145.38' to N & W in E side.
CL M-43 - N - 27.78'.

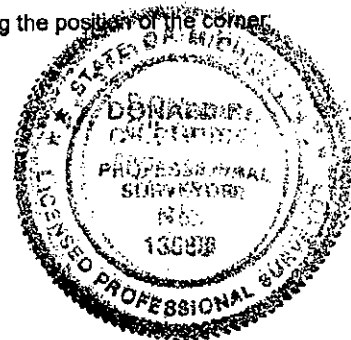

Signed by Donald R. Gilchrist
Surveyor's Michigan License No. RLS 13583

Date 12/2/96

4/13/1898 - G. Mutchler, C.S.

Book 5 Page 74. Found Stone and Stake.

Witnesses:

2" Sugar - S 53 Deg 30' E - 57 lks (37.62').

2" Sugar - S 62 Deg 45' W - 36 lks (23.76').

Measured East 19.93 chs (1315.38') to Eighth Post (Stake) and continued East 19.93 chs (1315.38') to Quarter Post (Stake and Stones) for a total of 2630.76'.

Measured West 19.725 chs (1301.85') to Eighth Post (Stake) and continued West 19.725 chs (1301.85') to Section Corner (Stake) for a total of 2603.70'.

12/14/1918 - Clair

Red Book. Iron Pipe.

4/1942 - M.D.O.T.

R/W Book.

Corner is 28.03' South of CL of Road.

Measured 2607.58' West to Section Corner.

Measured East 2628.57' to Section Corner.

10/18/1995 - Don R. Gilchrist, C.S.

Found 1/2" Iron - CL Highway North 27.78' - on Fence line to South 25'+-.

Distance East is 2627.65'. Distance West is 2608.29'.

LIBER 4 PAGE 388