

MAY 16 1997

DEC 10 8 24 AM '96

COMMISSION

LAND CORNER RECORDATION CERTIFICATE  
Filing Requirement of Act 74, Mich. P.A. 1970

Mark A. Smith  
VAN BUREN CO.  
SURVEYOR

9-00

For corners in Arlington Township

Van Buren County (County)	Located In:	Corner Code #
1. Public Land Survey SE Corner Sec 12	T2S R 15W	M-5
	T R	
	T R	
	T R	
2. Property Controlling in Section	S T R	
	S T R	
3. Miscellaneous Property in Sec.	S T R	
	S T R	

Register of Deeds Stamp & File Number

374 12/09 0101 10SURVEY

4. Lot No. \_\_\_\_\_, Recorded Plat \_\_\_\_\_

5. Private Claims \_\_\_\_\_

I, Donald R. Gilchrist, in a field survey on November 6, 1996 do hereby state that under requirements of P.A. 74, Michigan P.A. of 1970, the corner points mentioned in lines 1 and 2 above were in conformance with regulations and rules therefore as required in the current manual of survey instructions of the United States Department of the Interior, Bureau of Land Management or by a decree of a Court of Law and for that the corner points mentioned in lines 3, 4 and 5 above were in conformance with the rules of the Michigan Board of Land Surveyors or by a Decree of a Court of Law; established, re-established, monumented, recovered, found as expressed below:

	A	B	C	D	E	F	G	H	I	J	K	L
1												
2	6		5		4		3		2		1	
3												
4	7		8		9		10		11		12	
5												
6	18		17		16		15		14		13	
7												
8	19		20		21		22		23		24	
9												
10	30		29		28		27		26		25	
11												
12	31		32		33		34		35		36	
13												

NOTE: Not more than 2 corners, all in the same town and range, may be recorded on this certificate.

A. Description of original monument and accessories and/or subsequent restoration:  
**4/1827 - GOVERNMENT - W. Brookfield, D.S.**  
 North on East boundary of Section 13 a distance of 80.00 chs (5280.00') and set Post Corner to Sections 12 and 13.

**Witnesses:**  
 5" Willow - S 4 Deg 15' W - 34 lks (22.44')  
 18" Tamarack - North - 240 lks (158.40')

(Continued on back of Certificate)


B. Description of corner evidence found and/or method applied in restoring or reestablishing corner:  
 Found 1/2" Iron - 26.75' S of CL - M-43 on CL RD North.  
 Measured North to NE Corner = 5258.79'. Distance West is 2627.65'

Approved at the <sup>95</sup>10/25/96 meeting of the Van Buren County Peer Group and is accepted as the best available evidence of the position of the original corner.

Relieved by Peer Group in accordance with P.A. 345 of 1990  
 Van Buren County Surveyor  
 Date 12/19/96 D.R.G.

C. Description of monument for corner and accessories established to perpetuate locating the position of the corner:

Set Harrison Marker in Mon Box.  
 15" Elm - N 16 Deg E - 111.44'.  
 5" Will - N 15 Deg W - 108.08'.  
 M-43 Sign - N 68 Deg W - 146.26'.  
 M-43 Sign - S 89 Deg E - 103.71'.  
 CL of M-43 - N - 25.2'.  
 Town Line jog = 57.50' N.

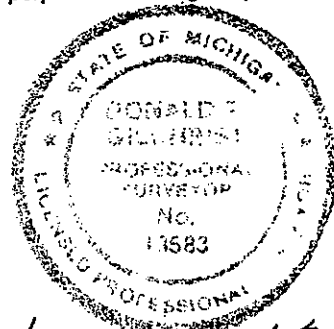

Signed by Donald R. Gilchrist  
 Surveyor's Michigan License No. RLS 13583

Date 12/2/96

**4/1898 - G. Mutchler, C.S.**

Book 5 - Page 74.

"Corner lost, but set 87 lks (57.42') South of Waverly Corner which was found. Set Stake and Stones."

Measured West 19.93 chs (1315.38') to Eighth Post and continued West 19.93 chs (1315.38') to Quarter Post (Stake and Stones) for a total of 2630.76'.

Measured North 19.91 chs (1314.06') to Eighth Post and continued North 19.91 chs (1314.06') to Quarter Post (Stake) for a total of 2628.12'.

**4/24/1922 - W. H. Goss, C.S.**

Red Book. Found Stone.

**Witnesses:**

East end Tube on North side of Road - NE - 73 lks (48.18').

West end Tube on North side of Road - NW - 74 lks (48.84').

**6/1939 - M.D.O.T.**

Found both Corners.

Jog is 57.42' South of Waverly Corner.

Waverly Corner is a Boat Spike in a Tile with witnesses and is 26.75' left of station 387 + 28.57.

Measured 2628.57' to South Quarter Post.

**10/18/1995 - Don R. Gilchrist, C.S.**

Found 1/2" Iron Bar - 26.75' South of Center Line of Highway.

*LIBER 4 PAGE 384*