

FILED

LAND CORNER RECORDATION CERTIFICATE

FILING REQUIREMENT OF ACT 74, MICH. P.A. 1970

APR 5 9 35 AM '99

SW COR SEC 11 BANGOR TWP.

Mark A. Smith
VAN BUREN COUNTY
REGISTER OF DEEDS

FOR CORNERS OF -:	LOCATED IN -:	CORNER CODE NUMBER
1. PUBLIC LAND SURVEY _____	T. <u>2</u> ^{XX} S., R. <u>16</u> ^{XX} W.	I-5
2. PROPERTY CONTROLLING IN SECTION _____	, T. _____ N. S., R. _____ E. W.	_____
3. MISCELLANEOUS PROPERTY IN SECTION _____	, T. _____ N. S., R. _____ E. W.	_____
4. LOT NO. _____, RECORDED PLAT _____		
5. PRIVATE CLAIMS _____		

REGISTER OF DEEDS STAMP AND FILING NUMBER

I, CHARLES D. LOSSIE, do hereby certify that under requirements of P.A. 74, Michigan P.A. of 1970, the corner points mentioned in lines 1 and 2 above were, in a field survey on MARCH 22, 1999, established, re-established, monumented, re-monumented, recovered or restored as expressed below and in conformance with regulations and rules therefore as required in the current manual of survey instructions of the United States Department of the Interior, Bureau of Land Management or by a decree of a court of law. Furthermore, that the corner points mentioned in lines 3, 4 and 5 above were, in a field survey on _____, 19____, found, recovered, restored, established or re-established as expressed below and in conformance with the rules of the Michigan State Board of Registration for Land Surveyors or, by a Decree of a Court of law:

A. Description of original monument and accessories and/or subsequent restoration:

4/1830- GOVERNMENT - G.W. HARRISON, D.S.
 RAN NORTH BETWEEN SECTIONS 14 AND 15 A DISTANCE OF 80.00 CHS.
 (5280.00') AND SET POST CORNER

WITNESSES:

20" BEECH - N. 73° E. 32 LKS. (21.12')
 18" BEECH - S. 86° W. 31 LKS. (20.46')

SURVEY & REPRODUCTION

DEC 28 1999

SEE BACK PAGE FOR ADDITIONAL CORNER HISTORY.

SECTION

B. Description of corner evidence found and/or method applied in restoring or re-establishing corner:

FOUND 1/2" COLD ROLLED PIPE TIED OFF PIPE AND DUG AND FOUND NOTHING. DISTANCE NORTH AGREES WITH GOSS OLD DISTANCE IN 10/24/1905. THE 1/2" PIPE IS ACCEPTED AS A CAREFUL AND FAITHFUL REESTABLISHMENT OF THE POSITION OF THE ORIGINAL CORNER AT THE PEER GROUP MEETING HELD ON 2/24/99.

C. Description of monument for corner and accessories established to perpetuate locating the position of the corner:


TIED OFF 1/2" PIPE. SET HARRISON MARKER AND MONUMENT BOX
 12" TWIN MAPLE S. 45° W. 31.09' TO P.K. AND WASHER
 06" TWIN MAPLE N. 80° W. 29.13' TO P.K. AND WASHER
 16" MAPLE N. 50° E. 60.15' TO P.K. AND WASHER
 18" SWEET GUM N. 85° E. 36.00' TO P.K. AND WASHER

Notified by Peer Group in accordance with P.A. 345 of 1990 Van Buren County Surveyor

4/5/99 *D.R.S.*

SIGNED BY Charles D. Lossie P.S.

SURVEYOR'S MICHIGAN REGISTRATION NO. 44291

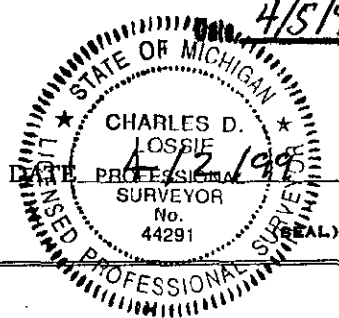

FOR STATE AND UNITED STATES AGENCIES:

SIGNED BY _____ CHIEF OF SURVEY PARTY

DATE _____

APPROVED AND SIGNED BY _____ MICHIGAN REGISTERED LAND SURVEYOR

DATE _____

(SEAL)

SURVEYOR'S MICHIGAN REGISTRATION NO. _____

Lib 5 Pg. 204

7921 04/05 0104 10SRVRY

9-00

Book 5 pg. 205

**SOUTHWEST CORNER OF SECTION 11
TOWN 2 SOUTH, RANGE 16 WEST IN BANGOR TOWNSHIP (I-5)**

4/29/1884-A.A. Fosdick, C.S.

Section 14

Book 5 - Page 5 & Red Book

The West Quarter Post having been kept by stake of previous survey (old witness trees gone). The same line, bearing and distance to Northwest Corner could not be identified. Producing the same to Quarter Post between Sections 10 and 11, and proportioning the distance as new point was found for corner from which roots of tree were found, which had the bearings of trees as given in field notes, and kind of wood could be clearly identified. The distance varied a few inches from notes, but I regard Northwest Corner as restored to a few inches of its original position.

Distance South is 39.895 chs. 2633.07'.

Distance East is 19.88 chs. (1312.08') and continuing 1312.08' to North Quarter Post for a total of 2624.16'.

Book 5 Page 27 & Red Book

All corners found satisfactory except Northwest Corner. This was restored by measuring from Southwest Corner to Northwest Corner. Also North Quarter Post to Northwest Corner. Some evidence of old witness trees were found, but it was doubtful testimony, and the corner was set on a line with West Quarter Post and the West Quarter Post of Section 11 and Northeast Corner through the North Quarter Post was produced to intersect the above line. Same distance as above.

3/31/1905-W.H. Goss, C.S.

Section 10

Red Book and Goss Notes

Found Stone

Witnesses:

4" Elm - NW. -40 lks. (26.40').

Distance North is 39.95 chs. (2636.7').

10/24/1905

Section 10

Book 7 - Page 16

Same information as above

10/30/1951 - T. A. Smith, C.S.

Section 10

Note Shows Corner

Distance North is 2637.35'.

SURVEY &

RF

DEC 28 1999

SECTION