

LAND CORNER RECORDATION CERTIFICATE
Filing Requirement of Act 74, Mich. P.A. 1970
 N 1/4 Post Sec. 11, Bangor Twp.

FILED

APR 5 9 37 AM '99

Mark A. Smith
 VAN BUREN CO.
 REGISTER OF DEEDS

Register of Deeds Stamp & File Number

For corners in

Van Buren Co _____ Located In: _____ Corner Code # J-3
 (County)

1. Public Land Survey T 2 S. R 16 W. J-3
 T _____ R _____
 T _____ R _____
 T _____ R _____

2. Property Controlling S _____ T _____ R _____
 in Section S _____ T _____ R _____

3. Miscellaneous S _____ T _____ R _____
 Property in Sec. S _____ T _____ R _____

4. Lot No. _____, Recorded Plat _____

5. Private Claims _____

I, Charles D. Lossie, in a field survey on March 18, 1999 do hereby state that under requirements of P.A. 74, Michigan P.A. of 1970, the corner points mentioned in lines 1 and 2 above were in conformance with regulations and rules therefore as required in the current manual of survey instructions of the United States Department of the Interior, Bureau of Land Management or by a decree of a Court of Law and /or that the corner points mentioned in lines 3, 4 and 5 above were in conformance with the rules of the Michigan Board of Land Surveyors or by a Decree of a Court of Law; established, re-established, monumented, recovered, found as expressed below:

NOTE: Not more than 2 corners, all in the same town and range, may be recorded on this certificate.

	A	B	C	D	E	F	G	H	I	J	K	L	M
1													
2	6		5		4		3		2		1		
3									●				
4	7		8		9		10		11		12		
5													
6	18		17		16		15		14		13		
7													
8	19		20		21		22		23		24		
9													
10	30		29		28		27		26		25		
11													
12	31		32		33		34		35		36		
13													

A. Description of original monument and accessories and/or subsequent restoration:
 4/1830- GOVERNMENT - G. W. HARRISON, D.S.
 Corrected the line between Sections 2 and 11 - 39.85 chs. (2630.10') and set Quarter Section Post.
 Witnesses:
 6" Beech N. 29° E., 4 lks (2.64')
 14" Sycamore S. 52° E., 11 lks (7.26")

SEE BACK PAGE FOR ADDITIONAL HISTORY


SURVEY &
 REF
 DEC 28 1999
 SECTION

B. Description of corner evidence found and/or method applied in restoring or reestablishing corner:
 Found 1/2" Iron bar on South side of old wood stake and stone. Stone is West of 1/2" Iron bar. The 1/2" Iron bar was accepted as a careful and faithful perpetuation of the position of the original corner at a Peer Group Meeting held on 2/24/99.

C. Description of monument for corner and accessories established to perpetuate locating the position of the corner:
 Tied off 1/2" Iron bar and wood stake. Set Harrison Marker.
 Power Pole N. 80° E., 17.54' to P.K. and Washer
 16" Maple South 34.17' to P.K. and Washer
 08" Twin Maple N. 05° E., 62.95' to P.K. and Washer.
 18" Maple S. 55° W, 44.64' to P.K. and Washer.

Signed by Charles D. Lossie

Surveyor's Michigan License No. 44291

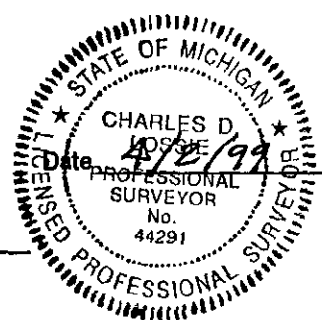

Ratified by Peer Group in accordance with P.A. 345 of 1990 Van Buren County Surveyor
 Date 4/5/99 D. B. A.

FORM APPROVED BY MICHIGAN STATE BOARD OF PROFESSIONAL SURVEYORS, JAN. 28, 1971
 REVISED MAY 14, 1975
 REVISED JAN, 1983
 REVISED OCT., 1985

7922 04/05 0104 10SURVEY 9.00
 P11.5 A4 217

Liber 5 Ag 213

North Quarter Post of Section 11
Town 2 South, Range 16 West in Bangor Township (J-3).

3/25/1871- A.J. Pierce, D.C.S.

Book 3 - Page 60 & Red Book

Stake at corner

Distance East is 19.86 chs. (1310.76') and continuing East 1310.76' to Section Corner for a total of 2621.52'.

4/8/1892- F.P. Lawton, C.S.

Section 11

Red Book

Stone at corner.

1902- W.H. Goss, C.S.

Found Stone

9/1935- T. A. Smith, C.S.

Section 2

Red Book

Distance East is 2624.7'.

1949- W.Q. Smith, C.S.

Found Stone

4/14/1976 - Section 2

Recorded Survey (Liber 6-Page 118).

Shows Quarter Section breakdown.

Distance West is 1308.54', and continuing West 1308.54' to Southwest Corner for a total of 2627.08'.

Distance North is 1315.83', and continuing North 1315.83' to Center Quarter Post for a total of 2631.66'.

2/7/1977-D.R. Gilchrist, C.S.

Recordation Certificate (Liber 2-Page 527).

Found oak stake with ring of stone around it, 0.50' North of corner fence post. Set 1/2" Iron bar on South edge of stake.

Witnesses:

12" Maple - S.40°W. -41.92' to nail.

8" Maple - S. 02° E. -24.18' to nail.

Power Pole - N. 85°E. -17.54' to nail.

12/7/1977- G. J. Mitchell, P.S.

Section 11

Found Rebar

Witnesses:

Corner Fence Post - S. 45°W. - 0.50'

Power Pole - N. 70° W. -17.50'

18" Maple- South 34.05'

8" Twin Maple- N. 10°E.; 63.23'.

SURVEY &
RECORDATION

DEC 28 1999

SECTION