

LAND CORNER RECORDATION CERTIFICATE

FILING REQUIREMENT OF ACT 74, MICH. P.A. 1970

§ 1/4 POST SECTION 11 BANGOR TOWNSHIP

FOR CORNERS OF--:	LOCATED IN--:	CORNER CODE NUMBER
1. PUBLIC LAND SURVEY _____	T. <u>2</u> ^{XX} S., R. <u>16</u> ^{XX} W.	J-5
2. PROPERTY CONTROLLING IN SECTION _____	, T. _____ N. S., R. _____ E. W.	
3. MISCELLANEOUS PROPERTY IN SECTION _____	, T. _____ N. S., R. _____ E. W.	
4. LOT NO. _____, RECORDED PLAT _____		
5. PRIVATE CLAIMS _____		

REGISTER OF DEEDS STAMP AND FILING NUMBER

FILED
APR 5 9 35 AM '99
Mark A. Smith
VAN BUREN CO. REGISTER OF DEEDS
FILED
APR 5 9 36 AM '99
Mark A. Smith
VAN BUREN CO. REGISTER OF DEEDS

I, CHARLES D. LOSSIE, do hereby certify that under requirements of P.A. 74, Michigan P.A. of 1970, the corner points mentioned in lines 1 and 2 above were, in a field survey on MARCH 16, 1999, established, re-established, monumented, re-monumented, recovered or restored as expressed below and in conformance with regulations and rules therefore as required in the current manual of survey instructions of the United States Department of the Interior, Bureau of Land Management or by a decree of a court of law. Furthermore, that the corner points mentioned in lines 3, 4 and 5 above were, in a field survey on _____, 19____, found, recovered, restored, established or re-established as expressed below and in conformance with the rules of the Michigan State Board of Registration for Land Surveyors or, by a Decree of a Court of law:

A. Description of original monument and accessories and/or subsequent restoration:

4/1830- GOVERNMENT, G.W. HARRISON, D.S.

RAN WEST ON CORRECTED LINE BETWEEN SECTIONS 11 AND 14 A DISTANCE OF 39.835 CHS. (2629.11') AND SET QUARTER POST.

WITNESSES:

- 11" RED OAK N. 32° E. 41 LKS (27.06')
- 8" WHITE OAK S. 31° W. 14 LKS (9.24')

SEE BACK PAGE FOR ADDITIONAL CORNER HISTORY.

B. Description of corner evidence found and/or method applied in restoring or re-establishing corner:

FOUND OLD BOTTLE AND CROCKERY FROM OLD GOSS WITNESSES TREES. USED BOTTLE FOR CORNER. THE BOTTLE WAS ACCEPTED AS A CAREFUL AND FAITHFUL PERPETUATION OF THE POSITION OF THE ORIGINAL CORNER AT THE PEER GROUP MEETING HELD ON 2/24/99

Ratified by Peer Group in accordance with P.A. 345 of 1990
Van Buren County Surveyor


Date 4/15/99 *D.P.A.*

C. Description of monument for corner and accessories established to perpetuate locating the position of the corner:

- TIED OFF OLD BOTTLE AND SET HARRISON MARKER
- 30" BEECH N. 08° E. 37.25' TO P.K. AND WASHER
- 30" BEECH S. 88° W. 34.31' TO P.K. AND WASHER
- 14" MAPLE S. 88° E. 16.67' TO P.K. AND WASHER
- 28" MAPLE S. 45° W. 51.30' TO P.K. AND WASHER

7921 04/05 0104 10SURVEY

SIGNED BY *Charles D. Lossie*
SURVEYOR'S MICHIGAN REGISTRATION NO. 44291

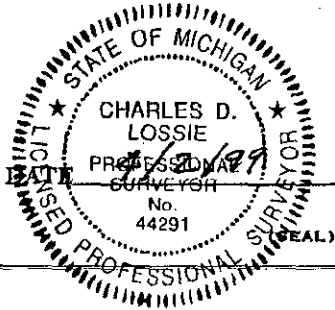

FOR STATE AND UNITED STATES AGENCIES:

SIGNED BY _____ DATE _____
CHIEF OF SURVEY PARTY

APPROVED AND SIGNED BY _____ DATE _____
MICHIGAN REGISTERED LAND SURVEYOR (SEAL)

SURVEYOR'S MICHIGAN REGISTRATION NO. _____

Libu 5 18 210

Book 5 Pg 211

**South Quarter Post of Section 11
Town 2 South, Range 16 West in Bangor Township (J-5)**

4/16/1874- A. J. Teed, C.S.

Section 14

Book 4 - Page 153

Found the ash standing and the log of the red oak lying down - set stake.

Distance South is 40.40 chs. (2666.40').

4/29/1884 - A. A. Fosdick, C.S.

Section 14

Book 5 Pages 5 & 27 - Red Book

North Quarter Post being identified from old witnesses.

Distance West is 19.88 chs. (1312.08'), and continuing West 19.88 chgs.

(1312.08') to Northwest Corner of Section for a total of 2624.16'.

Distance East is 39.575 chs. (2611.95') to Northeast Corner

Distance South is 19.925 chs (1315.05' and continuing South 19.925 chs.

(1315.05') to Center Quarter Post for a total of 2630.10'.

Witnesses:

10" Elm - N. 51° E. 18 lks.

4/8/1892 - F. P. Lawton, C.S.

Section 11

Found stone at Quarter Post

1900± - W. H. Goss, C.S.

Section 11

Notes Crockery

Witnesses:

14" Beech - S 88° W. 0.5 chs. (33.00')

12" Beech - N 09° E. 57.5 lks. (37.95').

Distance East is 39.78 chs. (2625.48')

3/21/1911 - W. V. Ackley, C.S.

Section 11

Book 7 - Page 160

Nothing on Quarter Post.

SURVEY &
REF

DEC 28 1999

SECTION