

LAND CORNER RECORDATION CERTIFICATE
FILING REQUIREMENT OF ACT 74, MICH. P.A. 1970

Dec 16 9 20 AM '99

S 1/4 Post, Sec 23 Arlington Twp.

FOR CORNERS OF:	LOCATED IN:	CORNER CODE NUMBER
1. PUBLIC LAND SURVEY _____, T. <u>2</u> S., R. <u>15</u> W.	<u>X</u> S., R. <u>15</u> W.	<u>J-9</u>
2. PROPERTY CONTROLLING IN SECTION _____, T. _____ S., R. _____ W.	N. E. S., R. _____ W.	
3. MISCELLANEOUS PROPERTY IN SECTION _____, T. _____ S., R. _____ W.	N. E. S., R. _____ W.	
4. LOT NO _____, RECORDED PLA _____		
5. PRIVATE CLAIMS _____		

Mark A. Smith
VAN BUREN CO.
REGISTER OF DEEDS

REGISTER OF DEEDS STAMP
AND FILING NUMBER

I, Charles D. Lossie, in a field survey on 13-Dec, 19 99 do hereby state that under requirements of P.A. 74, Michigan P.A. of 1970, the corner points mentioned in lines 1 and 2 above were in conformance with regulations and rules therefore as required in the current manual of survey instructions of the United States Department of the Interior, Bureau of Land Management or by a decree of a Court of Law and/or that the corner points mentioned in lines 3, 4 and 5 above were in conformance with the rules of the Michigan Board of Land Surveyors or by a Decree of a Court of Law; established, re-established, monumented, recovered, found as expressed below:

1	A	B	C	D	E	F	G	H	I	J	K	L	M
2		6		5		4		3		2		1	
3													
4		7		8		9		10		11		12	
5													
6		18		17		16		15		14		13	
7													
8		19		20		21		22		23		24	
9													
10		30		29		28		27		26		25	
11													
12		31		32		33		34		35		36	
13													

NOTE: Not More than 2 corners, all in the same town and range may be recorded on this certificate.

A. Description of original monument and accessories and/or subsequent restoration:
4/1830- GOVERNMENT - G.W. HARRISON, D.S.
Corrected West between Sections 23 and 26 a distance of 39.76 lks. (2624.16').

See back sheet for additional History


B. Description of corner evidence found and/or method applied in restoring or re-establishing corner:
Found railroad spike. The position of this Government Monument was accepted and restored with the approval of the Van Buren County Remonumentation Peer Group of Surveyor's meeting on 5/26/99 as the best available evidence of the position of the original corner.

Ratified by Peer Group in accordance with P.A. 345 of 1990
Van Buren County Surveyor

Date 12-16-99 D. R. A.

C. Description of monument for corner and accessories established to perpetuate locating the position of the corner:
Tie off railroad spike. Set slim line Harrison Marker in Monument Box.
14" Maple, North 55.95' to PK and Washer.
6" Cherry, S. 40° E., 29.86' to PK and Washer.
4" Maple, South 40.00' to PK and Washer.
36" Maple, N. 70° W., 183.04' to PK and Washer.

Signed by Charles D. Lossie
CHARLES D. LOSSIE, P.S.

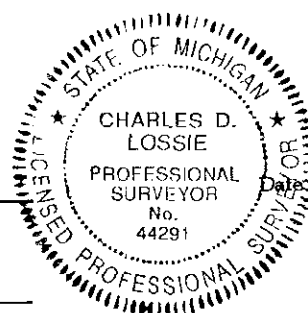

Date 12/15/99

Surveyor's Michigan License No. 44291

L. Lee 5 Pg 276

South Quarter Post, Sec 23,
Town 2 South, Range 15 W., Arlington Twp (J-9)

1/3/1868 - C.D. LAWTON, C.S.

Section 26

Book 2 - Page 49 & Red Book

Ran from Northeast Corner of Section 26, N. 87° E, 79.19 chs. (5226.54') and found Northwest Corner of Section - established Quarter Post midway at 2613.27'.

Witnesses:

24" Black Cherry - N. 43°-30' W., 97 lks. (64.02').

10" English Cherry (Red) - N. 23°-30' E., 112 lks. (73.92').

Distance West is 19.79 chs. (1306.14'), and continuing West 1306.14' to Northwest Corner of Section for a total of 2612.28'.

6/2/1904 - W.H. GOSS, C.S.

Section 26

Book 1 - Page 178, Goss Notes and Red Book.

Set 18" sleigh shoe and stone - opposite old fence.

Witnesses:

18" Apple - N. 18°-30' W., 70 lks. (46.20').

12" Apple - N. 22°-30' E., 100 lks. (66.00').

Total mile distance is 79.17 chs. (5225.22').

Distance West is 40.10 chs (2646.6').

Distance East is 39.07 chs. (2578.62').

Distance South is 19.975 chs. (1318.35') and continuing South 1318.35' to Center Quarter Post (iron bar and tile) for a total of 2636.70'.

3/20/1954 - W.Q. SMITH, C.S.

Section 23

Drawing shows corner as pipe.

Distance East is 2577.2'.