

Ratified by Peer Group in
 accordance with P.A. 345 of 1990
 Van Buren County Surveyor

Date 12-16-96 D. B. Z.

FILED

DEC 16 11 14 AM '96

REMONUMENTATION
 LAND CORNER RECORDATION CERTIFICATE
 Filing Requirement of Act 74, Mich. P.A. 1970

For corners in

VAN BUREN
 (County)

Located In:

Corner Code #

1. Public Land Survey
 SW corner, Sec. 1
 BANGOR TOWNSHIP


T 2S R 16W

K-3

2. Property Controlling
 in Section
 3. Miscellaneous
 Property in Sec.

S
 S
 S
 S

T
 T
 T
 T

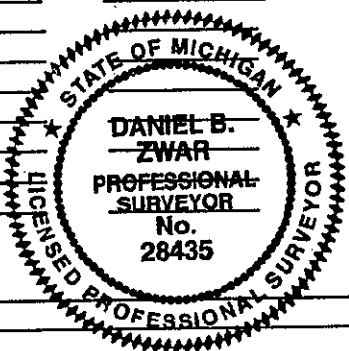

4. Lot No. _____, Recorded Plat _____
 5. Private Claims _____

Mark A. Smith
 VAN BUREN CO.
 REGISTER OF DEEDS
 SURVEY &
 REMONUMENTATION
 MAY 16 1997
 COMMISSION
 LIBER 4 PAGE 433
 Register of Deeds Stamp & File Number

7-00
12/16 0101 105URVEY

I, DANIEL B. ZWAR, in a field survey on MAY 17, 1996
 do hereby state that under requirements of P.A. 74, Michigan P.A. of 1970, the corner points mentioned in lines 1 and 2 above were in conformance with regulations and rules therefore as required in the current manual of survey instructions of the United States Department of the Interior, Bureau of Land Management or by a decree of a Court of Law and /or that the corner points mentioned in lines 3, 4 and 5 above were in conformance with the rules of the Michigan Board of Land Surveyors or by a Decree of a Court of Law; established, re-established, monumented, recovered, found as expressed below:

	A	B	C	D	E	F	G	H	I	J	K	L	M
1													
2	6		5		4		3		2		1		
3											●		
4	7		8		9		10		11		12		
5													
6	18		17		16		15		14		13		
7													
8	19		20		21		22		23		24		
9													
10	30		29		28		27		26		25		
11													
12	31		32		33		34		35		36		
13													

NOTE: Not more than 2 corners, all in the same town and range, may be recorded on this certificate.

A. Description of original monument and accessories and/or subsequent restoration:

- 1830 - G.W. HARRISON, D.S.; NORTH BETWEEN SECTIONS 11 & 12 A DISTANCE OF 80.00 CHS. AND SET POST CORNER; WITNESSES: 13" ELM - S 76° W 30 LNKS; 24" SUGAR MAPLE - S 81° E 3 LKS; DISTANCES - WEST 2630.1' TO 1/4 POST; EAST 39.70 CHS. TO 1/4 POST
- 1868 - A.J. PIERCE, D.C.S.; SECTION 12; BOOK 3 - PAGE 34; USED CORNER - WITNESS TREES GONE; DISTANCE EAST IS 39.72 CHS. (2621.52') TO 1/4 POST; DISTANCE SOUTH IS 39.64 CHS. (2616.24') TO 1/4 POST; 1869 - BOOK 3 - PAGE 60 (SECTION 2); RESET STAKE RENEWED; DISTANCE NORTH IS 39.86' CHS. (2630.76') TO 1/4 POST
- 1892 - F.R. LAWTON, C.S.; SECTION 11; BOOK 5 - PAGE 61; STONE & TILE; RED BOOK - STONE (MAYBE A WELL FILTER, LATER)
- 1902 - W.H. GOSS, C.S.; SECTION 1; RED BOOK; FOUND STONE; DISTANCE EAST IS 19.95 CHS. (1316.70') TO EIGHTH POST & CONTINUING EAST 1316.70' TO 1/4 POST FOR A TOTAL OF 2633.4'; DISTANCE WEST IS 19.87 CHS. (1310.76') TO EIGHTH POST & CONTINUING EAST 1310.76' TO 1/4 POST FOR A TOTAL OF 2621.52'
- 1935 - T.A. SMITH, C.S.; SECTION 2; RED BOOK; DISTANCE WEST IS 2624.9' TO 1/4 POST; 1936 - DISTANCE WEST IS 2624.7' TO 1/4 POST; DISTANCE EAST IS 1314.1' TO EIGHTH POST & CONTINUING EAST 1314.1' TO 1/4 POST FOR A TOTAL OF 2628.2'; 1936 - (SECTIONS 1 & 12) DRAWING SHOWS CORNER; DISTANCE EAST IS 1314.1' TO EIGHTH POST & CONTINUING EAST 1314.1' TO 1/4 POST FOR A TOTAL OF 2628.2'; 1947 (SECTION 11) - DRAWING SHOWS CORNER; DISTANCE SOUTH IS 2635.3'; DISTANCE WEST IS 2624.7'
- 1964 - W.Q. SMITH, C.S.; SECTIONS 1, 2 & 11; SHOWS CORNER; PIPE EAST 368.94'; PIPE WEST 356.23' & CONTINUING WEST 279.98'; PIPE SOUTH 465.3'; PIPE NORTH 790.0'; ANGLE NORTH TO WEST IS 91° 15'
- 1973 - M.D.O.T. - R/W MAPS; SHOWS CORNER; DISTANCE NORTH TO FENCE OF HIGHWAY IS 1279.52'
- 1973 - W.Q. SMITH, C.S. (D.A. MIDDLETON, R.L.S.); SECTION 1; RECORDED SURVEY (LIBER 5, PAGE 4); FOUND STONE; WITNESSES: STONE IS PART WAY DOWN WEST SIDE OF HILL & 8' ± EAST OF PINE TREE GROVE; I&M ELECTRIC POLE NO. B 310-635 IS S 10° E 58.27' TO NAIL; 3" MAPLE N 5° W 23.95' TO CENTER LINE DOWN-GUY POLE (NORTHERLY 1 TO 3) - S 50° E 28.01' TO BOLT AT GROUND; 1973 - RECORDATION CERTIFICATE (LIBER 2, PAGE 185); FOUND STONE & WITNESSES SAME AS ABOVE
- 1980 - M.D.O.T.; RECORDATION CERTIFICATE (LIBER 3, PAGE 40); FOUND POINTED STONE; WITNESSES: S 10° E 58.37' - P. POLE; S 50° W 10.43' - 5" PINE; N 15° W 30.47' - 5" PINE; EAST 41.66' - 10" CHERRY
- 1989 - D.R. GILCHRIST, C.S.; RECORDATION CERTIFICATE (LIBER 3, PAGE 139); FOUND POINTED STONE & SAME WITNESSES AS M.D.O.T.

B. Description of corner evidence found and/or method applied in restoring or reestablishing corner:

FOUND POINTED STONE & WITNESSES AS PER LIBER 3, PAGES 40 & 129. STRADDLED & REMOVED. FOUND SECOND VERY LARGE STONE BELOW FIRST (NO POINT). ORIGINAL WITNESSES ARE GONE. REMOVED SECOND STONE, NOTHING BELOW IT.

C. Description of monument for corner and accessories established to perpetuate locating the position of the corner:

PLACED REMONUMENTATION "HARRISON" MONUMENT TO STRADDLES, SET ABOUT TO GRADE. CORNER IS ACCEPTED AS A CAREFUL AND FAITHFUL PERPETUATION OF THE POSITION OF THE ORIGINAL CORNER. NEW WITNESSES: SET NAIL WITH TAG IN ELECT. POLE NO. 310-635 S 10° E 58.27'; SET NAIL W/ TAG IN 10" PINE N 15° W 30.47'; SET NAIL WITH TAG IN 10" PINE S 60° W 10.20'; SET NAIL WITH TAG IN 8" CHERRY EAST 29.50'

Signed by Daniel B. Zwar
 Surveyor's Michigan License No. 28435

Date Dec 16, 1996

24" Poplar - East - 28.39'.

LIBER 5 PAGE 11 K-5

8/16/1972 - Recorded Survey (Book 2 - Page 231).

Drawing shows corner - 1" iron pipe.

Witnesses same as above.

Distance North is 2633.32'.

Distance West is 1310.05' to Eighth Post, and continuing West 1310.05' to Quarter Post, and continuing 1311.60' to Eighth Post, and continuing 1311.60' to Southwest Corner of Section for a total of 5242.22'.

Angle West to North is 89 Deg 02' 50".

8/14/1973 - D. A. Ratekin, R.L.S.

Section 12.

Recorded Survey (Liber 4 - Page 307).

Found 2" pipe.

Witnesses:

Face of 9" Maple - West - 48.5'.

Nail in Power Pole - S 35 Deg E - 67.42'.

Nail in Telephone Pole - S 35 Deg W - 68.48'.

3/17/1980 - D. R. Gilchrist, C.S.

Section 12.

Recorded Survey (Liber 8 - Page 286).

Found 2-1/2" iron bar.

Witnesses:

Power Pole - S 30 Deg E - 67.45'.

24" Poplar - East - 28.35'.

Telephone Cable Box - S 30 Deg W - 68.55'.

12/10/1980 - Recorded Survey (Liber 8 - Page 316), Section 13.

Found 3" steel shaft and witnesses the same as above.

Distance South is 1319.30', and continuing South 1319.59' to Quarter Post for a total of 2638.89'.

Distance East to Westerly right of way line of railroad is 1134.25'.

11/21/1980 - Recorded Survey (Liber 8 - Page 275), Section 12.

Found 2-1/2" iron bar and witnesses same as above.

12/10/1980 - Recorded Survey (Liber 8 - Page 282), Section 13.

Shows corner and witnesses the same as above.

Distance South is 1319.30', and continuing South 1319.59' to Quarter Post for a total of 2638.89'.

Distance East is 2622.31' to Quarter Post.












**SURVEY &
REMONUMENTATION**

JAN 14 1998

SECTION

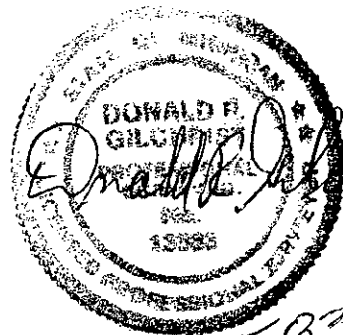

Donald R. Gilchrist
#13583