

Ratified by Peer Group in accordance with P.A. 345 of 1990 Van Buren County Surveyor

Date 12-16-96 D. B. Z.


REMONUMENTATION LAND CORNER RECORDATION CERTIFICATE Filing Requirement of Act 74, Mich. P.A. 1970

Dec 16 11 14 AM '96

Mark A. Smith VAN BUREN CO. REGISTER OF DEEDS

For corners in

Form with fields for County (VAN BUREN), Located In (T2S R17W), Corner Code # (G-11), and numbered items 1-5 describing the survey area.

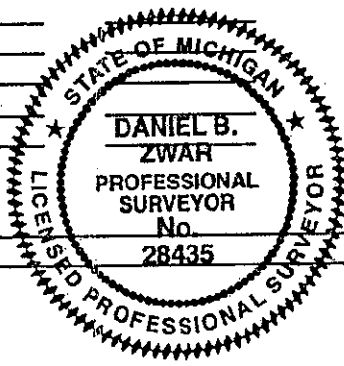

SURVEY & REMONUMENTATION

MAY 16 1997

COMMISSION LIBER 4 PAGE 431

Register of Deeds Stamp & File Number

Grid table with columns A-L and rows 1-13. A black dot is located at the intersection of column G and row 11.

I, DANIEL B. ZWAR, in a field survey on NOVEMBER 5, 1996, do hereby state that under requirements of P.A. 74, Michigan P.A. of 1970, the corner points mentioned in lines 1 and 2 above were in conformance with regulations and rules...

NOTE: Not more than 2 corners, all in the same town and range, may be recorded on this certificate.

A. Description of original monument and accessories and/or subsequent restoration:

- List of survey descriptions including: 1830 - W. BROOKFIELD, D.S.; 1869 - A.J. PIERCE, D.C.S.; 1971 - W.Q. SMITH, C.S.; 1974 - R. GARRETT, R.L.S.; 1977 - D.R. GILCHRIST, C.S.; 1980 - M.R. RUSHLOW, R.L.S.; 1982 - ELMER STEFAN & WALLY STREBS.

(CONTINUED ON BACK)

B. Description of corner evidence found and/or method applied in restoring or reestablishing corner:

FOUND 1/2" IRON ROD IN MON BOX AND WITNESSES MATCHED THOSE OF 1989. STRADDLED AND REMOVED ROD (FOUND TO BE 18" LONG). DUG TO A DEPTH OF 3' FOUND NOTHING BUT SAND. ORIGINAL WITNESSES GONE. THE LOCATION OF THIS ROD IS ACCEPTED AS THE BEST AVAILABLE EVIDENCE OF THE POSITION OF THE ORIGINAL CORNER.

C. Description of monument for corner and accessories established to perpetuate locating the position of the corner:

PLACED REMONUMENTATION "HARRISON" MONUMENT IN MON. BOX, COMPACTED AND COLD PATCHED. WITNESSES: NAIL WITH TAG IN POWER POLE 425-48 S 55° W 50.68'; NAIL WITH TAG IN CIVIL DEFENSE POLE S 25° E 72.27'; NAIL WITH TAG IN 4" POPLAR N 40° E 60.68'; NAIL WITH TAG IN GUY POLE #393-10 N 45° W 57.58'

Signed by Daniel B. Zwar Surveyor's Michigan License No. 28435

Date Dec 16, 1996

LIBER 4 PAGE 432

- 1988 - THE ABONMARCHE GROUP; SECTION 34; NOTES SHOW; IRON IN MONUMENT BOX; DISTANCE EAST IS 2631.355'; DISTANCE SOUTH IS 2635.34' TO 1/4 POST AND CONTINUING SOUTH 2632.60' TO SOUTHWEST CORNER FOR A TOTAL OF 5267.94'; ANGLE FROM SOUTH TO EAST IS 89° 40'20"
- 1989 - D.R. GILCHRIST, C.S.; SECTION 34; SURVEY DRAWING; IRON IN MONUMENT BOX; WITNESSES: GUY POLE S 45° E 30.76'; GUY POLE N 45° W 57.75'; UTILITY POLE S 45° W 50.42'; 2.1 SOUTH OF CENTER LINE CR 376; IN CENTER LINE 76TH STREET
- 1990 - THE ABONMARCHE GROUP; SECTION 34; NOTES SHOW; IRON IN MONUMENT BOX; DISTANCE EAST IS 2631.40' TO 1/4 POST AND CONTINUING EAST 2627.94' TO NORTHEAST CORNER FOR A TOTAL OF 5259.34'