

NOV 15 1994

FILED

LIBER 4 PAGE 151 COMMISSION

LAND CORNER RECORDATION CERTIFICATE
Filing Requirement of Act 74, Mich. P.A. 1970

Oct 18 12 02 PM '94

For corners in

Van Buren County,
Antwerp Township

Located In:

Corner Code #

- 1. Public Land Survey T R
SW Corner, Section 19 T 3S R 13W A, 9
- T R
- T R
- 2. Property Controlling S T R
in Section S T R
- 3. Miscellaneous S T R
Property in Sec. S T R

Mark A. Smith
VAN BUREN CO
REGISTERED SURVEYOR

9.00
7361 10/18/94 0101 10SURVEY

Register of Deeds Stamp & File Number

- 4. Lot No. _____, Recorded Plat _____
- 5. Private Claims _____

	A	B	C	D	E	F	G	H	I	J	K	L	M
2	6		5		4		3		2		1		
3													
4	7		8		9		10		11		12		
5													
6	16		17		18		19		20		21		
7													
8	19		20		21		22		23		24		
9													
10	30		29		28		27		26		25		
11													
12	31		32		33		34		35		36		
13													

I, Don R. Gilchrist, in a field survey on June 22, 19 1994, do hereby certify that under requirements of P.A. 74, Michigan P.A. of 1970, the corner points mentioned in lines 1 and 2 above were in conformance with regulations and rules therefore as required in the current manual of survey instructions of the United States Department of the Interior, Bureau of Land Management or by a decree of a Court of Law and/or that the corner points mentioned in lines 3, 4 and 5 above were in conformance with the rules of the Michigan Board of Land Surveyors or by a Decree of a Court of Law; established, re-established, monumented, re-monumented, recovered, found as expressed below:

NOTE: Not more than 4 corners, all in the same town and range, may be recorded on this certificate.

A. Description of original monument and accessories and/or subsequent restoration:
Government Set Post - 35 Lk, North Half of Corner, Town 3 South, Range 14 West
14" White Oak - N56-30' East - 20 LK
22" White Oak - S31- 15 East - 31 LK

Field Note - by unknown - (date n/a) Stone
T. A. Smith - 4/10/24 - Found Stone and Iron 7' North of the centerline travel a
23.1' North of P.P. Corner


J. Stack - 11/31/68 - Found Iron and Stone
W.Q. Smith, County Surveyor, Found Corner, 10/13/68 - 7/15/70 5/9/73
D.R. Gilchrist, County Surveyor, 9/26/91 found washing machine crank over pipe,
2' North of centerline of road, and 23.12' North of P.P. Corner,

B. Description of corner evidence found and/or method applied in restoring or reestablishing corner:
Cor Field checked by D. R. Gilchrist, County Surveyor on 6/22/94 - Found
Harrison Marker
Cor Re-approved by County Peer Group on 6/29/94 and is accepted as a careful
and faithful perpetuation of the position of the Original Government Corner.

Ratified by Peer Group in
accordance with P.A. 345 of 1990
Van Buren County Surveyor

Date D. R. G. 10/18/94

C. Description of monument for corner and accessories established to perpetuate locating the position of the corner:
Harrison Marker
Power Pole South 50.93' - PK Nail West Side
Power Pole N60W 46.97' - PK Nail West Side
Railroad Tie Fence Post, North 38.52' - PK Nail West Side
24" White Oak, N60°E - 63.21' - PK Nail East Side
3' North of Center of Road
23.12' Jog North of PP Corner

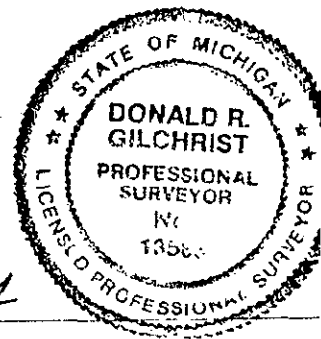

Signed by Donald R. Gilchrist Date 10/18/94
Surveyor's Michigan License No. 13583

LIBERTY PAGE 152.

Continuation of "A":

Set Monument Box.

D.R. Gilchrist, County Surveyor, 8/15/92 approved by County Peer Group

Set Harrison Marker - L3 - P245