

VAN BUREN COUNTY REMONUMENTATION PROGRAM

FILED

LAND CORNER RECORDATION CERTIFICATE
Filing Requirement of Act 74, Mich. P.A. 1970

Dec 17 8 11 AM '96

For corners in ANTWERP TWP.

Van Buren _____ Located In: _____ Corner Code # _____
(County)

1. Public Land Survey T 3 S. R 13 W. C-3
SW corner Sec. 5 T _____ R _____
T _____ R _____
T _____ R _____

2. Property Controlling S _____ T _____ R _____
in Section S _____ T _____ R _____

3. Miscellaneous S _____ T _____ R _____
Property in Sec. S _____ T _____ R _____

Mark A. Smith
VAN BUREN CO.
REGISTER OF DEEDS

SURVEY &
REMONUMENTATION
MAY 1 6 1997
COMMISSION
Register of Deeds Stamp & File Number

4. Lot No. _____, Recorded Plat _____
5. Private Claims _____

A	B	C	D	E	F	G	H	I	J	K	L	M
2	6	5	4	3	2	1						
3												
4	7	8	9	10	11	12						
5												
6	18	17	16	15	14	13						
7												
8	19	20	21	22	23	24						
9												
10	30	29	28	27	26	25						
11												
12	31	32	33	34	35	36						
13												

John C. Hunt, P.S. November 23 1996
I, _____, in a field survey on _____, 19_____,
do hereby certify that under requirements of P.A. 74, Michigan P.A. of 1970, the corner points mentioned
in lines 1 and 2 above were in conformance with regulations and rules therefore as required in the
current manual of survey instructions of the United States Department of the Interior, Bureau of Land
Management or by a decree of a Court of Law and/or that the corner points mentioned in lines 3, 4 and 5
above were in conformance with the rules of the Michigan Board of Land Surveyors or by a Decree of a
Court of Law; established, re-established, monumented, re-monumented, recovered, found as
expressed below:

NOTE: Not more than 4 corners, all in the same town and range, may be recorded
on this certificate.


A. Description of original monument and accessories and/or subsequent restoration:
11/1829 Gov. W. Brookfield DS: Ran N. bet. sec. 7-8 80 chs. & set post cor. Wit.: 12" w.oak S°33W 74 lks.
16" w.oak N73°E 120 lks. Dist. E. 5266.8', W. 4296.6'. 11/30/1848 S.Blackman CS: Sec.8 Bk.1 p.5, shows
dist. E.20 chs. to 1/8th post & cont. E. 20 chs. to ¼ post totaling 2640'. 1900+- W.Goss CS, Sec. 8,
notes stone. Wit.: 18" sugar NW 34.98', 18" sugar NE 40.92'; dist. S. 5320.92'. 5/14/1924 T.Smith CS:
Red bk., fd. stone--Goss wit. OK. Dist. W. to ¼ post 2665.40'; dist. S. to ¼ post 2659.30'. 4/17/1972
E.Stefan RLS: Sec. 5 sq. iron bar. Wit.: Top tel. riser S25°E 47', 20" tree W. 37.9', 24" tree N35°E
40.1'. 8/31/1972 D.Gilchrist RLS: Sec. 7 rec. survey L.3 p.23, fd. RR spike. Wit.: 28" oak W. 39' to
nail, 16" maple N45°W 53.71' to nail, 30" maple N45°E 41.78' to nail. 10/23/1972 LCRC L.1 p.564. Fd. RR
spike as per T.Smith 5/14/1924 & agreed w/ old wit. 9/23/1976 A.McMachen RLS: Sec. 8 Fd. RR spike & wit.
per Gilchrist; 2/15/1978 LCRC L.2 p.521. 12/18/1991 J.Hunt PS, Rec. survey L.9 p.296. Dist. S. 2659.52'.

B. Description of corner evidence found and/or method applied in restoring or reestablishing corner:
C-3 SW Corner Sec. 5 T3S-R13W Antwerp Twp., Van Buren Co., MI. Corner common to sections 5, 6, 7, & 8.
Found railroad spike over pointed stone in centerline of road North & South and 3' S. of centerline of
road to East. Removed & set Harrison Marker in monument box.

THIS GOVERNMENT MONUMENT WAS RESTORED WITH APPROVAL OF THE VAN BUREN COUNTY REMONUMENTATION PEER GROUP
OF SURVEYORS AT A MEETING HELD ON October 30, 1996, AND IS ACCEPTED AS A CAREFUL AND FAITHFUL
PERPETUATION OF THE POSITION OF THE ORIGINAL CORNER.

Ratified by Peer Group in
accordance with P.A. 345 of 1996
Van Buren County Surveyor
Date 12/16/96 *J. R. G.*

C. Description of monument for corner and accessories established to perpetuate locating the position of the corner:
C-3 HARRISON MARKER IN MONUMENT BOX
N37°W 55.03' Set nail & washer in Northerly root of 24" Maple tree.
S89°W 38.94' Set nail & washer in North base of 28" Oak tree.
N65°E 63.89' Set nail & washer in Southerly root of 30" Maple tree.
S28°E 45.90' to NW corner of telephone cable box.

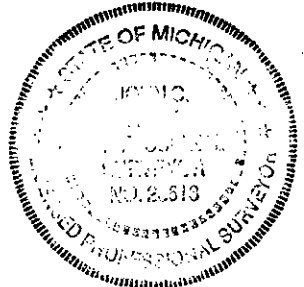

Signed by *John C. Hunt, P.S.* Date Dec 12, 1996
Surveyor's Michigan License No. 23513

Lib 4 Sec. 445