

Nov 19 9 46 AM '98

LAND CORNER RECORDATION CERTIFICATE

SW. COR, SEC 9

Filing Requirement of Act 74, Mich. P.A. 1970

Mark A. Smith  
VAN BUREN CO  
REGISTER OF DEEDS

9-00

LIBER 5 PAGE 130

For corners in Antwerp Township

Van Buren (County)	Located In:	Corner Code #
1. Public Land Survey	T 3S R 13W	E-5
	T R	
	T R	
	T R	
	T R	
2. Property Controlling in Section	S T R	
	S T R	
3. Miscellaneous Property in Sec.	S T R	
	S T R	

LIBER 5 PAGE 130  
Register of Deeds Stamp & File Number

4. Lot No. \_\_\_\_\_, Recorded Plat \_\_\_\_\_  
 5. Private Claims \_\_\_\_\_

I, Donald R. Gilchrist in a field survey on July 28, 1998 do hereby state that under requirements of P.A. 74, Michigan P.A. of 1970, the corner points mentioned in lines 1 and 2 above were in conformance with regulations and rules therefore as required in the current manual of survey instructions of the United States Department of the Interior, Bureau of Land Management or by a decree of a Court of Law and for that the corner points mentioned in lines 3, 4 and 5 above were in conformance with the rules of the Michigan Board of Land Surveyors or by a Decree of a Court of Law, established, re-established, monumented, recovered, found as expressed below.

NOTE: Not more than 2 corners, all in the same town and range, may be recorded on this certificate.

	A	B	C	D	E	F	G	H	I	J	K	L	M
1													
2	6			5		4		3		2		1	
3													
4	7			8		9		10		11		12	
5													
6	18			17		16		15		14		13	
7													
8	19			20		21		22		23		24	
9													
10	30			29		28		27		26		25	
11													
12	31			32		33		34		35		36	
13													

A. Description of original monument and accessories and/or subsequent restoration:  
 12/1829 - GOVERNMENT - William Brookfield, D.S.  
 Ran North between Sections 16 and 17 a distance of 80.00 chs. (5280.00')

Witnesses:  
 14" Yellow Oak - S 63° 30' W - 90 lks. (59.40')  
 16" Yellow Oak - N 27° W - 1.07 lks. (70.62')

Distance East is 78.50 chs. (5181.00')  
 Distance West is 79.70 chs. (5260.20')  
 (Continued on back of Certificate)

Ratified by Peer Group in accordance with P.A. 345 of 1990  
 Van Buren County Surveyor  
 Date D.R.G. 11/19/98

B. Description of corner evidence found and/or method applied in restoring or reestablishing corner:  
 Found 1/2" pipe at surface. Found 3/4" pipe under.


Approved at the 7/28/98 Van Buren County Peer Group Meeting and is accepted as the best available evidence of the position of the original corner.

C. Description of monument for corner and accessories established to perpetuate locating the position of the corner:

Set Harrison Marker over 3/4" pipe.  
 48" Maple - S 40° E - 46.40'.  
 P.P. - S 80° E - 19.15'.  
 P.P. - S 20° W - 90.35'.  
 48" Maple - North 70° W - 74.52'.  
 1.6' W of Centerline S.

SURVEY & REMONUMENTATION  
 JAN 11 1999  
 SECTION

Signed by Donald R. Gilchrist  
 Surveyor's Michigan License No. RLS 13583

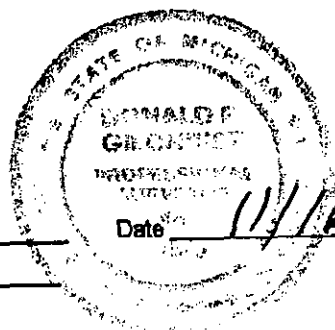

No Date - Red Book.

**Witnesses:**

Road Sign - East - 14.3'.  
 36" Maple - N 25° E - 75.8'.  
 24" Maple - S 45° E - 46.4'.

Eighth Post to the West.

12/29/1949 - T.A. Smith, C.S.

Section 17. Notes show corner as an iron.

7/31/1951 - W.Q. Smith, C.S.

Section 9. Drawing shows corner.

11/27/1954 - Note shows corner with distance South of 1335.6'.

10/29/1955 - Note shows distance West is 1324.28', 1324.28", 1321.00' & 1321.00' for a total of 5290.56'.

1959 - MDOT R/W MAPS.

Shows corner. Distance North to centerline of I-94 Highway is 1158.34'.

8/22/1961 - W.Q. Smith, C.S.

Section 17. Note shows corner.

Distance West is 1324.28'. Distance North is 2650.76'.

8/24/1961 - Drawing shows corner.

Distance West is 1324.28'. Distance North is 1325.00'.

2/11/1972 - Notes show corner. Distance West is 2647.84'.

2/24/1972 - Recorded Survey (Liber 1 - Page 294).

Found 1/2" iron.

**Witnesses:**

36" Maple - S 45° E - 45.23' to nail and tab on Northerly side.  
 26" Maple - S 50° W - 68.43' to nail and tab on Southeast side.  
 Utility Pole - S 85° E 21.00' to nail and tab on North side.

3/1/1972 - Recordation Certificate (Liber 1 - Page 222) (D. A. Middleton).

Found 1/2" pipe, witnesses same as above.

7/7/1972 - Recorded Survey (Liber 2 - Page 146).

Found 1/2" pipe, witnesses same as above.

7/7/1972 - Recorded Survey (Liber 2 - Page 166).

Found 1/2" iron, witnesses same as above.

2/26/1974 - Recorded Survey (Liber 5 - Page 22).

Section 16. Found 1/2" iron, witnesses same as above.

Distance South is 2675.29'. Distance East is 2590.30'.

4/3/1974 - Recorded Survey (Liber 5 - Page 54) Section 8.

Found 1/2" iron, witnesses same as above.

Distance West is 2647.84'.

4/3/1974 - Recorded Survey (Liber 5 - Page 56).

Found 1/2" iron, witnesses same as above.

4/3/1974 - Recorded Survey (Liber 5 - Page 58).

Found 1/2" iron, witnesses same as above.

5/12/1978 - D.R. Gilchrist - (Alpha).

Section 16. Recorded Survey (Liber 8 - Page 148).

Found 1/2" iron, witnesses same as above.

Distance East is 2591.21'. Distance South is 2675.36'.

6/27/1978 - T.J. Woldering, R.L.S.

Sections 9 & 16. Recorded Survey (Liber 8 - Page 1).

Found 1/2" iron, witnesses same as W.Q. Smith in 1972.

Distance East is 2590.30'. Distance South is 2675.29'. Distance North is 2650.67'.

6/6/1991 - D.R. Gilchrist, C.S.

Sections 9 & 16. Found 1/2" iron, witnesses same as W.Q. Smith in 1972.

Distance South is 2647.23'. Distance North is 2650.67'. Distance East is 2590.30'.

10/1/1992 - J.C. Hunt, P.S.

Section 9. Recorded Survey (Liber 9 - Page 366).

Found 1/2" iron.

**Witnesses:**

N 60° E - 40.20' to nail in Northeast face of pole.  
 S 35° W - 39.96' to nail in Southeast face of pole.  
 N 40° W - 58.09' to nail in East base of 20" Maple.  
 N 70° E - 56.00' to pk nail in South base of 9" tree.

Southwest corner distance North is 2650.62'.

11/14/1994 - Recorded Survey (Liber 10 - Page 140).

Section 8. Found 1/2" iron.

**Witnesses:**

S 45° E - 45.18' to nail & tag in North face of 36" Maple.  
 S 85° E - 21.00' to nail & tag in North face of utility pole.  
 N 70° W - 75.03' to pk nail in South face of 34" Maple.  
 S 20° W - 90.14' to pk nail in North face of pole.

SURVEY &  
 REMONUMENTATION

JAN 11 1999

SECTION