

SURVEY & REMONUMENTATION

FILED

APR 25 1995

COMMISSION

LAND CORNER RECORDATION CERTIFICATE
Filing Requirement of Act 74, Mich. P.A. 1970

DEC 22 9 29 AM '94

For corners in

Van Buren
(County)

Located In: Antwerp

Corner Code #

Mark A. Smith
VAN BUREN CO.
REGISTERED LAND SURVEYOR

- | | | | |
|------------------------------------|-----------------------------------|----------------------------|-------------|
| 1. Public Land Survey | <u>3/4 Post</u>
<u>SEC. 28</u> | T <u>3 S</u> R <u>13 W</u> | <u>F-11</u> |
| | | T _____ R _____ | _____ |
| | | T _____ R _____ | _____ |
| | | T _____ R _____ | _____ |
| 2. Property Controlling in Section | S _____ | T _____ R _____ | _____ |
| | S _____ | T _____ R _____ | _____ |
| 3. Miscellaneous Property in Sec. | S _____ | T _____ R _____ | _____ |
| | S _____ | T _____ R _____ | _____ |

LIBER 4 PAGE 243

Register of Deeds Stamp & File Number

4. Lot No. _____, Recorded Plat _____
5. Private Claims _____

I, James E. Boynton, in a field survey on July 1, 1994, do hereby certify that under requirements of P.A. 74, Michigan P.A. of 1970, the corner points mentioned in lines 1 and 2 above were in conformance with regulations and rules therefore as required in the current manual of survey instructions of the United States Department of the Interior, Bureau of Land Management or by a decree of a Court of Law and/or that the corner points mentioned in lines 3, 4 and 5 above were in conformance with the rules of the Michigan Board of Land Surveyors or by a Decree of a Court of Law; established, re-established, monumented, re-monumented, recovered, found as expressed below:

	A	B	C	D	E	F	G	H	I	J	K	L	M
2	6		5		4		3		2		1		
3													
4	7		8		9		10		11		12		
5													
6	18		17		16		15		14		13		
7													
8	19		20		21		22		23		24		
9													
10	30		29		28		27		26		25		
11													
12	31		32		33		34		35		36		
13													

NOTE: Not more than 4 corners, all in the same town and range, may be recorded on this certificate.

A. Description of original monument and accessories and/or subsequent restoration:

Original corner established in 1829 by William Brookfield, D.S. - not found, w.v. Ackley, C.S. found stake in 1909. T.A. Smith, C.S. found and used stone in 1924. L.C.R.C. by w.q. Smith, C.S. in 1971

B. Description of corner evidence found and/or method applied in restoring or reestablishing corner:

Found 1/4" iron bar in mon. box from witnesses. Dug out iron and found 8" x 10" x 20" stone under. Accepted as best evidence of original corner.


Ratified by Peer Group in accordance with P.A. 345 of 1990
Van Buren County Surveyor

Date J. R. J. 12/20/94

C. Description of monument for corner and accessories established to perpetuate locating the position of the corner:

Set standard marker over stone as directed by Peer Group on June 29, 1994.

*42" Oak N. 45° W. 47.66' to nail
40" Maple N. 35° E. 62.72' to nail
P.P. N. 75° E. 53.59' to nail
near corner of base to Kinney monument
N. 80° W. 50.85'*

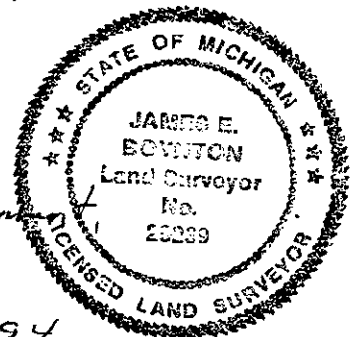

Signed by James E. Boynton
Surveyor's Michigan License No. 29239

Date 12-18-94