

SURVEY & REMONUMENTATION

FILED

JAN 11 1999

Nov 19 9 15 AM '98

SECTION

LAND CORNER RECORDATION CERTIFICATE
Filing Requirement of Act 74, Mich. P.A. 1970


For corners in

Van Buren Located In: _____ Corner Code # _____
(County) NW Cor. Sec. 27, Antwerp Township

1. Public Land Survey T 3 S R 13 W _____ G-9 _____
T _____ R _____
T _____ R _____
T _____ R _____

2. Property Controlling S _____ T _____ R _____
in Section S _____ T _____ R _____

3. Miscellaneous S _____ T _____ R _____
Property in Sec. S _____ T _____ R _____

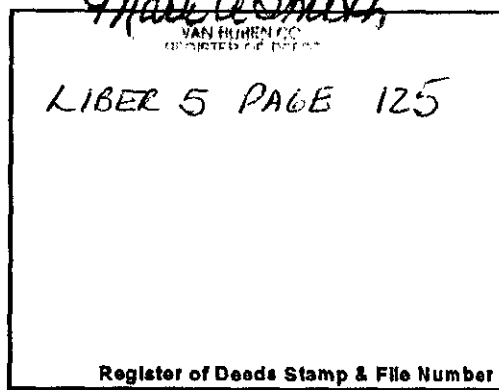


4. Lot No. _____, Recorded Plat _____
5. Private Claims _____

I, James E. Boynton, in a field survey on _____, 1997 do hereby certify that under requirements of P.A. 74, Michigan P.A. of 1970, the corner points mentioned in lines 1 and 2 above were in conformance with regulations and rules therefore as required in the current manual of survey instructions of the United States Department of the Interior, Bureau of Land Management or by a decree of a Court of Law and for that the corner points mentioned in lines 3, 4 and 5 above were in conformance with the rules of the Michigan Board of Land Surveyors or by a Decree of a Court of Law; established, re-established, monumented, re-monumented, recovered, found as expressed below:

1	A	B	C	D	E	F	G	H	I	J	K	L	M
2		6		5		4		3		2		1	
3													
4		7		8		9		10		11		12	
5													
6		18		17		16		15		14		13	
7													
8		19		20		21		22		23		24	
9													
10		30		29		28		27		26		25	
11													
12		31		32		33		34		35		36	
13													

NOTE: Not more than 4 corners, all in the same town and range, may be recorded on this certificate.

- A. Description of original monument and accessories and/or subsequent restoration:
Original corner position established in 1829 by William Brookfield, D.S. In 1868 C. D. Lawton found one witness tree and placed good Oak stake. In 1901 G. Muchler found a stone and one witness. In 1905 W. H. Goss found a stone. In 1959 W. Q. Smith found a pipe. In 1973 A. H. McMachen found a 1/2" pipe from the 1905 witnesses. This corner was used many times through 1990 but no description of the corner was given.
- B. Description of corner evidence found and/or method applied in restoring or reestablishing corner:
Found a 1/2" iron bar from 1973 witnesses and accepted as the best available evidence of the corner location. Also found iron bar by John Hunt 32.96 feet to the east. By observation the roadway has been cut about 3 feet.
- C. Description of monument for corner and accessories established to perpetuate locating the position of the corner:
Set Standard Remon Monument in place of the pipe as directed by the Peer Group during the regular meeting of July 30, 1998.
MON. IS 3' EAST OF THE CENTERLINE OF CR-657.
UTILITY POLE N.44°-40'E. 57.98' TO NAIL
30" MAPLE S.72°-43'E. 38.00' TO NAIL
36" MAPLE S.30°-11'E. 65.02' TO NAIL
UTILITY POLE S.71°W. 85.72' TO NAIL

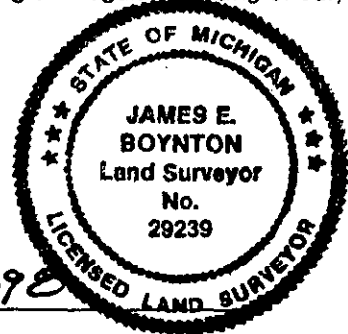

Signed by James E. Boynton Date 11-17-98
Surveyor's Michigan License No. 29239

FORM APPROVED BY MICHIGAN STATE BOARD OF LAND SURVEYORS, JAN. 28, 1971
REVISED MAY 14, 1975
REVISED JAN., 1983

Ratified by Peer Group in accordance with P.A. 345 of 1990
Van Buren County Surveyor

Date D.R.G. 11/19/98

2161 11/19 0101 10SURVEY 7-00