

JAN 17 1996

DEC 22 9 52 AM '95

COMMISSION

LAND CORNER RECORDATION CERTIFICATE
Filing Requirement of Act 74, Mich. P.A. 1970

For corners in

Van Buren
(County)
Antwerp Twp.

Located In: S.W. Cor. Sec. 34 Corner Code #
G-13

Mark A. Smith
VAN BUREN CO.
REGISTERED DEEDS

- 1. Public Land Survey T 3 S R 13 W G-13
- 2. Property Controlling in Section S T R
- 3. Miscellaneous Property in Sec. S T R

Register of Deeds Stamp & File Number

- 4. Lot No. _____, Recorded Plat _____
- 5. Private Claims _____

	A	B	C	D	E	F	G	H	I	J	K	L	M
2	6	5	4	3	2	1							
3													
4	7	8	9	10	11	12							
5													
6	16	17	16	15	14	13							
7													
8	19	20	21	22	23	24							
9													
10	30	29	28	27	26	25							
11													
12	31	32	33	34	35	36							
13													

I, James E. Boynton, in a field survey on October 12, 19 95, do hereby certify that under requirements of P.A. 74, Michigan P.A. of 1970, the corner points mentioned in lines 1 and 2 above were in conformance with regulations and rules therefore as required in the current manual of survey instructions of the United States Department of the Interior, Bureau of Land Management or by a decree of a Court of Law and/or that the corner points mentioned in lines 3, 4 and 5 above were in conformance with the rules of the Michigan Board of Land Surveyors or by a Decree of a Court of Law; established, re-established, monumented, re-monumented, recovered, found as expressed below:

NOTE: Not more than 4 corners, all in the same town and range, may be recorded on this certificate.

A. Description of original monument and accessories and/or subsequent restoration:

1827, original corner established by William Brookfield, D.S.
undated, W.H. Goss, D.S. found stone
1923, stone found at surface and in center of road by T.A. Smith, C.S.
1954, found stone in center of road by W.Q. Smith, C.S.
1967, found 1/2" pipe from 1954 witnesses

B. Description of corner evidence found and/or method applied in restoring or reestablishing corner:

Found pipe over stone from above witnesses. Accepted stone as best evidence of original corner.


Ratified by Peer Group in accordance with P.A. 345 of 1990
Van Buren County Surveyor

Date 7-26-95 D.R.A.

C. Description of monument for corner and accessories established to perpetuate locating the position of the corner:

Set standard marker in place of stone as directed by the Peer Group on July 26, 1995.

Tele. P. N. 70° E, 88.19'
30" Maple S. 52° E, 85.63'
24" Maple S. 45° W, 33.76'
20" Spruce N. 45° W, 44.10'
Porter corner 40.90' East.

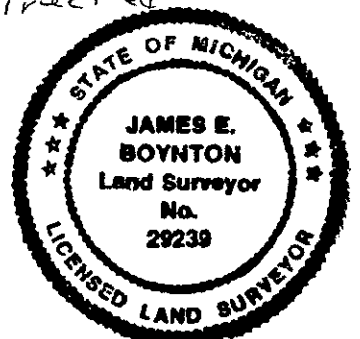

Signed by James E. Boynton Date December 17, 1995
Surveyor's Michigan License No. 29239

Libco 4 79 341