

SURVEY & REMONUMENTATION

JAN 14 1998

LAND CORNER RECORDATION CERTIFICATE
Filing Requirement of Act 74, Mich. P.A. 1970

SECTION

For corners in

Filed
DEC 15 3 56 PM '97

Mark A. Smith
VAN BUREN CO.
REGISTER OF DEEDS

7-00
455 12/15 0104 105URVEY

Van Buren (County) Located In: Antwerp Township Corner Code # W. 1/4 SEC. 11


1. Public Land Survey T 3 S R 13 W 14
 T _____ R _____
 T _____ R _____
 T _____ R _____

2. Property Controlling in Section S _____ T _____ R _____
 S _____ T _____ R _____

3. Miscellaneous Property in Sec. S _____ T _____ R _____
 S _____ T _____ R _____

4. Lot No. _____, Recorded Plat _____

5. Private Claims _____

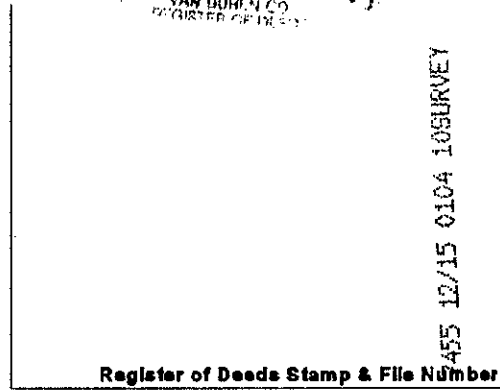

I, James E. Boynton, in a field survey on August 18, 1997 do hereby certify that under requirements of P.A. 74, Michigan P.A. of 1970, the corner points mentioned in lines 1 and 2 above were in conformance with regulations and rules therefore as required in the current manual of survey instructions of the United States Department of the Interior, Bureau of Land Management or by a decree of a Court of Law and /or that the corner points mentioned in lines 3, 4 and 5 above were in conformance with the rules of the Michigan Board of Land Surveyors or by a Decree of a Court of Law; established, re-established, monumented, re-monumented, recovered, found as expressed below:

NOTE: Not more than 4 corners, all in the same town and range, may be recorded on this certificate.


	A	B	C	D	E	F	G	H	I	J	K	L	M
1													
2		6		5		4		3		2		1	
3													
4		7		8		9		10	●	11		12	
5													
6		10		17		16		15		14		13	
7													
8		19		20		21		22		23		24	
9													
10		30		29		28		27		26		25	
11													
12		31		32		33		34		35		36	
13													

A. Description of original monument and accessories and/or subsequent restoration:
 Original corner position established in 1830 by William Brookfield, D.S. The corner was used in 1884 by A. A. Fosdick, C.S. but no description of the corner was given. In 1946 the corner was used by T. A. Smith, C.S. and referenced as a pipe. The 1/2" pipe was used by in 1958, 1972, 1979, 1981, and 1985 by several surveyors.

B. Description of corner evidence found and/or method applied in restoring or reestablishing corner:
 Found a 1/2" pipe from witnesses and accepted as the best available evidence of the corner location.

C. Description of monument for corner and accessories established to perpetuate locating the position of the corner:
 Set Standard Remon Monument in place of the pipe as directed by the Peer Group during the regular meeting of July 30, 1997.

- Mon. is 14' East of the centerline of 26th Street and in the centerline of West Point Drive
- 28" Oak S.89°W. 84.54' to nail
- 10" & 12" Oak S.12°E. 39.40' to nail in 10"
- 20" Oak S.26°W. 62.99' to nail
- 15" Oak N.12°E. 41.22' to nail

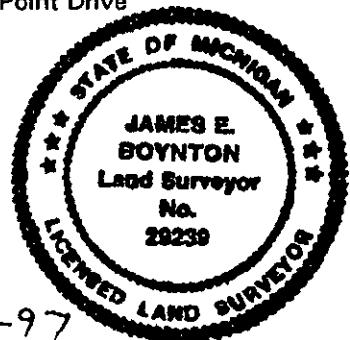

Signed by James E. Boynton Date 12-12-97
 Surveyor's Michigan License No. 29239

Ratified by Peer Group in accordance with P.A. 345 of 1990
 Van Buren County Surveyor

Date D. R. A. 12/15/97

Liber 5 Pg. 37