

LAND CORNER RECORDATION CERTIFICATE
Filing Requirement of Act 74, Mich. P.A. 1970

9.00
MAY 10 10/01 10 SURVEY

For corners in
VAN BUREN
(County)

Located In: Corner Code #

- 1. Public Land Survey SECTION 1 ANTWERP TWP. T 35 R 13 W K2
- 2. Property Controlling in Section S _____ T _____ R _____
- 3. Miscellaneous Property in Sec. S _____ T _____ R _____

Register of Deeds Stamp & File Number

- 4. Lot No. _____, Recorded Plat _____
- 5. Private Claims _____

	A	B	C	D	E	F	G	H	I	J	K	L
2	6	5	4	3	2	1						
3												
4	7	8	9	10	11	12						
5												
6	18	17	16	15	14	13						
7												
8	19	20	21	22	23	24						
9												
10	30	29	28	27	26	25						
11												
12	31	32	33	34	35	36						
13												

I, JAMES E. BOYNTON, in a field survey on MAY 14, 19 93, do hereby certify that under requirements of P.A. 74, Michigan P.A. of 1970, the corner points mentioned in lines 1 and 2 above were in conformance with regulations and rules therefore as required in the current manual of survey instructions of the United States Department of the Interior, Bureau of Land Management or by a decree of a Court of Law and/or that the corner points mentioned in lines 3, 4 and 5 above were in conformance with the rules of the Michigan Board of Land Surveyors or by a Decree of a Court of Law; established, re-established, monumented, re-monumented, recovered, found as expressed below:

NOTE: Not more than 4 corners, all in the same town and range, may be recorded on this certificate.

A. Description of original monument and accessories and/or subsequent restoration:

G.L.O., 1829
SET POST
12" WHITE OAK N. 41° W. 136 Lk.
10" WHITE OAK N. 71 3/4° E 215 Lk.


SEE OVER FOR CONTINUATION

B. Description of corner evidence found and/or method applied in restoring or reestablishing corner:

FOUND 1/2" IRON OVER R.R. SPIKE OVER 1 1/2" PIPE

C. Description of monument for corner and accessories established to perpetuate locating the position of the corner:

REPLACED 1/2" IRON AND R.R. SPIKE WITH STANDARD MONUMENT AS DIRECTED BY REMONUMENTATION PEER GROUP ON APRIL 28, 1993
P.K. NAIL IN P.P. / CABLE N. 07° 01' E. 126.37'
P.K. NAIL IN P.P. / LIGHT N. 56° 09' E. 29.79'
P.K. NAIL IN 15" MAPLE S. 74° 38' E. 43.65'
P.K. NAIL IN P.P. / LIGHT S. 83° 01' W. 86.29'

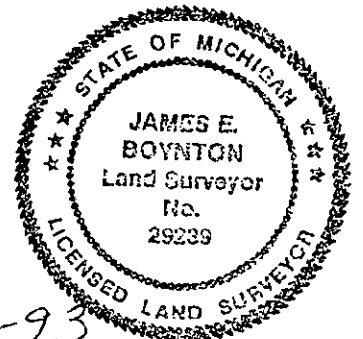

Signed by James E. Boynton
Surveyor's Michigan License No. 29239

Date 7-13-93

LIBER 4 PAGE 49

K 2

A, CONTINUATION

CORNER USED IN 1867 IN SURVEY BY C.W. LAWTON,
COUNTY SURVEYOR

SURVEY IN EARLY 1900'S FROM RED BOOK SHOWS PIPE
WITH FOLLOWING WITNESSES:
16" MAPLE N. 33° 30' E 7.2 LK (47.52') TO FACE
PLUS OTHERS

1923 SURVEY BY T.A. SMITH, COUNTY SURVEYOR, SHOWS
FOUND PIPE AND SET NEW PIPE OVER AND
THE FOLLOWING WITNESS AMONG OTHERS:
20" MAPLE N 33° E 48.5' TO ♀

USED IN NUMEROUS SURVEYS IN 1942, 1947,
1954, 1957, 1959, 1960, 1972, 1973, 1976, 1979,
1980, 1983, 1989 AND 1990 ALL CALLING FOR
THE CORNER BEING 58.8' ± SOUTH OF CENTERLINE
OF RED ARROW HIGHWAY.

CORNER INITIALLY RECORDED IN L. 2 ON PAGE 25
AND RE-RECORDED IN L. 2 ON PAGE 590
AND L. 3 ON PAGE 72.