

LAND CORNER RECORDATION CERTIFICATE
Filing Requirement of Act 74, Mich. P.A. 1970

Mark A Smith
MICHIGAN BOARD OF LAND SURVEYORS

OCT 1 3 26 PM '93

FILED

For corners in

VAN BUREN
(County)

Located in:

Corner Code #

- 1. Public Land Survey SECTION 12 ANTWERP TWP, T 35 R 13W Corner Code # K5
- 2. Property Controlling in Section S ___ T ___ R ___
- 3. Miscellaneous Property in Sec. S ___ T ___ R ___

Register of Deeds Stamp & File Number

- 4. Lot No. _____, Recorded Plat _____
- 5. Private Claims _____

A	B	C	D	E	F	G	H	I	J	K	L
2	6	5	4	3	2						
3											
4	7	8	9	10	11	12					
5											
6	18	17	16	15	14	13					
7											
8	19	20	21	22	23	24					
9											
10	30	29	28	27	26	25					
11											
12	31	32	33	34	35	36					
13											

I, JAMES E. BOYNTON, in a field survey on MAY 28, 19 93, do hereby certify that under requirements of P.A. 74, Michigan P.A. of 1970, the corner points mentioned in lines 1 and 2 above were in conformance with regulations and rules therefore as required in the current manual of survey instructions of the United States Department of the Interior, Bureau of Land Management or by a decree of a Court of Law and/or that the corner points mentioned in lines 3, 4 and 5 above were in conformance with the rules of the Michigan Board of Land Surveyors or by a Decree of a Court of Law; established, re-established, monumented, re-monumented, recovered, found as expressed below:

NOTE: Not more than 4 corners, all in the same town and range, may be recorded on this certificate.

A. Description of original monument and accessories and/or subsequent restoration:

G.L.O. 1829
SET POST
11" YELLOW OAK N 62° E 20 LK.
12" WHITE OAK S. 18° 30' E 60 LK.

SEE OVER FOR CONTINUATION

B. Description of corner evidence found and/or method applied in restoring or reestablishing corner:

FOUND 1/2" PIPE 6" LONG

REMONUMENTATION

1993


COMMISSION

C. Description of monument for corner and accessories established to perpetuate locating the position of the corner:

REPLACED PIPE WITH STANDARD MONUMENT AS DICTATED BY REMONUMENTATION FEER GROUP ON MAY 26, 1993.
DOUBLE HEADED NAIL IN P.P. W/LIGHT N. 11° 23' W. 153.66'
DOUBLE HEADED NAIL IN P.P. W/METER N. 63° 57' E. 44.82'
DOUBLE HEADED NAIL IN P.P. W/CABLE S. 23° 27' E. 66.33'
P.K. NAIL IN P.P. /LIGHT S. 43° 05' W. 45.04'

Signed by James E. Boynton
Surveyor's Michigan License No. 29239

Date 7-13-93

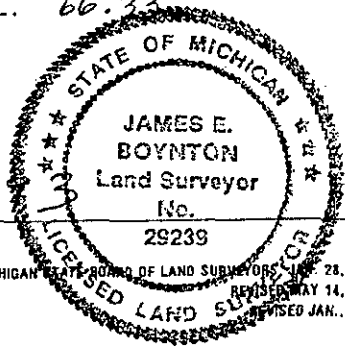

3733 10/01 9801 10SURVEY 9.00

A, CONTINUED

USED BY COUNTY SURVEYORS FOSDICK & ACKLEY BUT
NO WITNESSES GIVEN

1900 ± W. H. GOSS, COUNTY SURVEYOR :
STONE
OAK N.E. 53 LK. (34.98')

1920 ± H. Ward, COUNTY ROAD COMMISSION
STONE
27" WHITE OAK N. 49°30'E. 35'
AND OTHERS

1923 T.A. SMITH, SO' COUNTY SURVEYOR
STONE IN ROAD INTERSECTION
SAME WITNESSES AS WARD

USED IN NUMEROUS SURVEYS IN 1935, 1946, 1949, 1957, & 1959, BUT
NO WITNESSES NOR PHYSICAL FEATURES GIVEN.

1972 CORNER RECORDED IN L. 1 ON PAGE 466
AS FOUND PIPE IN MON. BOX

USED IN NUMEROUS SURVEYS IN 1973, 1974, 1977, 1980 & 1992
CALLING FOR SAME PIPE & RE-RECORDED IN L. 3 ON PAGE 19.

SHOWN ON RECORDED SURVEY IN L. 9 ON PAGE 354 DATED
7-17-92 BY D.R. GILCHRIST, COUNTY SURVEYOR SHOWING
WITNESS: 36" OAK N.E. 36.38'