

LAND CORNER RECORDATION CERTIFICATE
Filing Requirement of Act 74, Mich. P.A. 1970

For corners in

VAN BUREN
(County)

Located In:

Corner Code #

- 1. Public Land Survey T 35 R 13 W K-6
SECTION 13
ANTWERP TWP. T _____ R _____
T _____ R _____
T _____ R _____
- 2. Property Controlling S _____ T _____ R _____
in Section S _____ T _____ R _____
- 3. Miscellaneous S _____ T _____ R _____
Property in Sec. S _____ T _____ R _____

Register of Deeds Stamp & File Number

- 4. Lot No. _____, Recorded Plat _____
- 5. Private Claims _____

	A	B	C	D	E	F	G	H	I	J	K	L
2	6		5		4		3		2		1	
3												
4	7		8		9		10		11		12	
5												
6	18		17		16		15		14		13	
7												
8	19		20		21		22		23		24	
9												
10	30		29		28		27		26		25	
11												
12	31		32		33		34		35		36	
13												

I, JAMES E. BOYNTON, in a field survey on MAY 25, 19 93, do hereby certify that under requirements of P.A. 74, Michigan P.A. of 1970, the corner points mentioned in lines 1 and 2 above were in conformance with regulations and rules therefore as required in the current manual of survey instructions of the United States Department of the Interior, Bureau of Land Management or by a decree of a Court of Law and/or that the corner points mentioned in lines 3, 4 and 5 above were in conformance with the rules of the Michigan Board of Land Surveyors or by a Decree of a Court of Law; established, re-established, monumented, re-monumented, recovered, found as expressed below:

NOTE: Not more than 4 corners, all in the same town and range, may be recorded on this certificate.

A. Description of original monument and accessories and/or subsequent restoration:

G L O , 1829
SET POST
7" WHITE OAK S. 23° W 11 LK
12" YELLOW OAK N. 64° 30' W. 37 LK

SEE OVER FOR CONTINUATION

B. Description of corner evidence found and/or method applied in restoring or reestablishing corner:

FOUND 2 1/2" PIPE 4 1/2' LONG.

C. Description of monument for corner and accessories established to perpetuate locating the position of the corner:


REPLACED 2 1/2" PIPE WITH STANDARD MONUMENT AS DIRECTED BY THE REMONUMENTATION PEER GROUP ON MARCH 24th, 1993.
DOUBLE HEADED NAIL IN 36" MAPLE N. 28° 00' 14" E 107.88'
DOUBLE HEADED NAIL IN 36" MAPLE N. 72° 35' E. 73.42'
DOUBLE HEADED NAIL IN P.P. W/TRANSFORMER S. 10° 38' W. 104.26'
Q CONCORD ST. NORTH 163'

Signed by James E. Boynton
Surveyor's Michigan License No. 29239

Date July 13

FILED
OCT 1 3 26 PM '93
M. A. Smith
VAN BUREN CO
REGISTER OF DEEDS

1993
COMMISSION

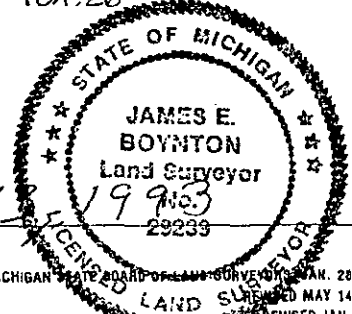

LIBER 4 PAGE 51

A. CONTINUATION

1857, F. H. BLACKMAN USED CORNER IN SURVEY OF THE VILLAGE OF MATTAWAN.

1913±, CORNER USED BY W. H. GOSS, COUNTY SURVEYOR IN SURVEY AND SHOWING FOLLOWING WITNESSES:
 24" MAPLE S. 78° 30' E. 75 LK.
 24" MAPLE N. 55° 15' E. 91.33 LK.
 STREET CORNER 1.89 ch. NORTH

1935, T. A. SMITH, COUNTY SURVEYOR FOUND PIPE DOWN 5" AND SHOWED WITNESSES AS FOLLOWS:
 30" MAPLE S. 78° E. 50.65' TO SPIKE
 30" MAPLE N. 60° E. 61.3' TO SPIKE

USED IN NUMEROUS SURVEYS DATED 1935, 1946, 1956, 1959, 1965, 1966, 1960, 1962, 1968, 1971, 1972, 1974, and 1992 INDICATING PERPETUATION OF THE PIPE.

CORNER RECORDED IN L. 1 ON PAGE 152