

SURVEY & REMONUMENTATION

APR 25 1995

FILED

COMMISSION

DEC 22 9 03 AM '94

S 1/4 SEC. 12

LAND CORNER RECORDATION CERTIFICATE

Filing Requirement of Act 74, Mich. P.A. 1970

For corners in ANTWERP TWP.

Mark A. Smith
VAN BUREN CO. SURVEYOR

VAN BUREN (County)	Located In:	Corner Code #
1. Public Land Survey	T <u>3</u> S R <u>13</u> W	<u>L-5</u>
	T _____ R _____	_____
	T _____ R _____	_____
	T _____ R _____	_____
2. Property Controlling in Section	S _____ T _____ R _____	_____
	S _____ T _____ R _____	_____
3. Miscellaneous Property in Sec.	S _____ T _____ R _____	_____
	S _____ T _____ R _____	_____

Register of Deeds Stamp & File Number

4. Lot No. _____, Recorded Plat _____
5. Private Claims _____

	A	B	C	D	E	F	G	H	I	J	K	L	M
2	6		5		4		3		2		1		
3													
4	7		8		9		10		11		12		
5													
6	18		17		16		15		14		13		
7													
8	19		20		21		22		23		24		
9													
10	30		29		28		27		26		25		
11													
12	31		32		33		34		35		36		
13													

I, Allen H. McMachen a field survey on December 17, 19 94, do hereby certify that under requirements of P.A. 74, Michigan P.A. of 1970, the corner points mentioned in lines 1 and 2 above were in conformance with regulations and rules therefore as required in the current manual of survey instructions of the United States Department of the Interior, Bureau of Land Management or by a decree of a Court of Law and/or that the corner points mentioned in lines 3, 4 and 5 above were in conformance with the rules of the Michigan Board of Land Surveyors or by a Decree of a Court of Law; established, re-established, monumented, re-monumented, recovered, found as expressed below:


NOTE: Not more than 4 corners, all in the same town and range, may be recorded on this certificate.

A. Description of original monument and accessories and/or subsequent restoration:

- 1829 - William Brookfield, D. S.
Set post
- 1884 - A.A. Fosdick, C.S.
"Found corner well marked by a stone" 14" B. Oak N. 40° E. 36 lks.
- 1927 - T.A. Smith, C.S.
Found stone with point up 18" below surface, 5' North of centerline of travel, R.R. "T" - Rail crossing sign post N. 45° E. 29.2' to near edge, gage line, near rail N. 40° W. 20.0'

B. Description of corner evidence found and/or method applied in restoring or reestablishing corner:

Found 1/2" iron pipe in monument box, removed monument box and pipe and found stone about 2' below surface. Stone was approved and authorized by the Van Buren County Remonumentation Peer Group.

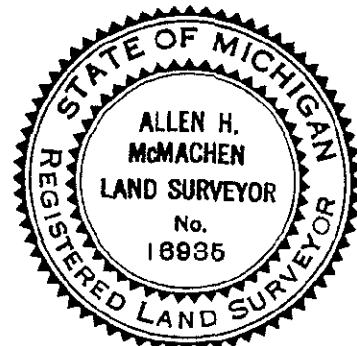

C. Description of monument for corner and accessories established to perpetuate locating the position of the corner:

Found stone is accepted as a careful and faithful PERPETUATION of the original corner. Removed pipe and placed standard Van Buren County section corner monument over stone and placed monument box over, accessories:

- Top center of Southeast bolt on railroad crossing signal N. 02° E. 18.88'
- Top center of Northeast bolt on railroad crossing signal S. 70° W. 63.45'
- Nail & tab in telephone pedestal pole S. 45° E. 45.39'
- Nail & tab in 24" Walnut S. 65° E. 68.29'

Notified by Peer Group in accordance with P.A. 345 of 1990 Van Buren County Surveyor

Signed by Allen H. McMachen
Surveyor's Michigan License No. 16935

Date 12/21/94 12/21/94 DR9

Lib 4 12/21/94