

*Max A. Smith*  
VAN BUREN CO.  
REGISTER (2nd DEPT)

LAND CORNER RECORDATION CERTIFICATE  
Filing Requirement of Act 74, Mich. P.A. 1970

7.00

For corners in

Van Buren  
(County)

S.E. COR.  
SEC. 36

Located In: Almena

Corner Code #

1. Public Land Survey

T 2S R 13W  
T 3S R 13W

M-13  
M-1 ✓

2. Property Controlling in Section

S \_\_\_ T \_\_\_ R \_\_\_  
S \_\_\_ T \_\_\_ R \_\_\_

3. Miscellaneous Property in Sec.

S \_\_\_ T \_\_\_ R \_\_\_  
S \_\_\_ T \_\_\_ R \_\_\_

LIBER 4 PAGE 242

Register of Deeds Stamp & File Number

4. Lot No. \_\_\_\_\_, Recorded Plat \_\_\_\_\_

5. Private Claims \_\_\_\_\_

	A	B	C	D	E	F	G	H	I	J	K	L	M
2	6		5		4		3		2				
3													
4	7		8		9		10		11		12		
5													
6	13		17		16		15		14		13		
7													
8	19		20		21		22		23		24		
9													
10	30		29		28		27		26		25		
11													
12	31		32		33		34		35		36		
13													

I, James E. Boynton, in a field survey on August 18, 19 94, do hereby certify that under requirements of P.A. 74, Michigan P.A. of 1970, the corner points mentioned in lines 1 and 2 above were in conformance with regulations and rules therefore as required in the current manual of survey instructions of the United States Department of the Interior, Bureau of Land Management or by a decree of a Court of Law and/or that the corner points mentioned in lines 3, 4 and 5 above were in conformance with the rules of the Michigan Board of Land Surveyors or by a Decree of a Court of Law; established, re-established, monumented, re-monumented, recovered, found as expressed below:

NOTE: Not more than 4 corners, all in the same town and range, may be recorded on this certificate.

A. Description of original monument and accessories and/or subsequent restoration:

*Original corner established in 1827 by William Brookfield, D.S. - not found.  
A.A. Fosdick, C.S. found and used corner in 1886, no call for character of corner.  
W.H. Goss, C.S. found stones from Fosdick witnesses, in 1905.  
L. Winther, P.S. found 3/4" pipe in 1971.  
W.G. Smith, P.S. found pipe over stone and reset with 1/2" iron in Mon. Box. in 1976.*

B. Description of corner evidence found and/or method applied in restoring or reestablishing corner:


*Found 1/2" iron in mon. box from 1976 witnesses, and accepted over stone as best evidence of original corner.*

Ratified by Peer Group in accordance with P.A. 345 of 1990  
Van Buren County Surveyor

Date J.R.A. 12/20/94

C. Description of monument for corner and accessories established to perpetuate locating the position of the corner:

*Set standard marker in place of iron and stone as directed by Peer Group on July 27, 1994.  
Corner is in centerline road:  
33" Oak S.20°W. 63.47' to Nail.  
18" Hickory S.65°W. 34.55' to nail.  
10" Spruce N.30°W. 59.41' to nail.  
14" Oak N.25°E. 91.05' to nail.*

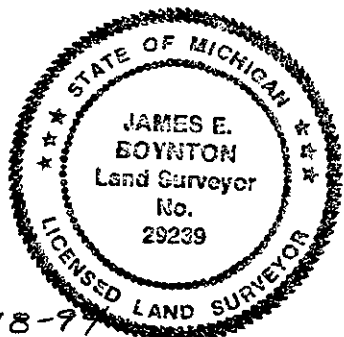

Signed by James E. Boynton  
Surveyor's Michigan License No. 29239

Date 12-18-94