

**SURVEY & REMONUMENTATION**

FILED

APR 25 1995

DEC 22 9 03 AM '94

COMMISSION

NE COR SEC. 12

LAND CORNER RECORDATION CERTIFICATE  
Filing Requirement of Act 74, Mich. P.A. 1970

For corners in ANTWERP TWP.

*Mark A. Smith*  
VAN BUREN CO.  
REGISTERED SURVEYOR

VAN BUREN (County) Located In: \_\_\_\_\_ Corner Code M-3

1. Public Land Survey T 3 S R 13 W \_\_\_\_\_  
T \_\_\_\_\_ R \_\_\_\_\_  
T \_\_\_\_\_ R \_\_\_\_\_  
T \_\_\_\_\_ R \_\_\_\_\_

2. Property Controlling S \_\_\_\_\_ T \_\_\_\_\_ R \_\_\_\_\_  
in Section S \_\_\_\_\_ T \_\_\_\_\_ R \_\_\_\_\_

3. Miscellaneous S \_\_\_\_\_ T \_\_\_\_\_ R \_\_\_\_\_  
Property in Sec. S \_\_\_\_\_ T \_\_\_\_\_ R \_\_\_\_\_

Register of Deeds Stamp & File Number

4. Lot No. \_\_\_\_\_, Recorded Plat \_\_\_\_\_  
5. Private Claims \_\_\_\_\_

	A	B	C	D	E	F	G	H	I	J	K	L	M
2	6	5	4	3	2	1							
3													
4	7	8	9	10	11	12							
5													
6	18	17	16	15	14	13							
7													
8	19	20	21	22	23	24							
9													
10	30	29	28	27	26	25							
11													
12	31	32	33	34	35	36							

I, Allen H. McMachen a field survey on December 17, 19 94, do hereby certify that under requirements of P.A. 74, Michigan P.A. of 1970, the corner points mentioned in lines 1 and 2 above were in conformance with regulations and rules therefore as required in the current manual of survey instructions of the United States Department of the Interior, Bureau of Land Management or by a decree of a Court of Law and/or that the corner points mentioned in lines 3, 4 and 5 above were in conformance with the rules of the Michigan Board of Land Surveyors or by a Decree of a Court of Law; established, re-established, monumented, re-monumented, recovered, found as expressed below:

**NOTE: Not more than 4 corners, all in the same town and range, may be recorded on this certificate.**

A. Description of original monument and accessories and/or subsequent restoration:

1827 - William Brookfield, D.S.  
Set Post

1884 - A.A. Fosdick, C.S.  
"Corner was lost, but restored it from the established corner of Sec. 6 and 7 of Texas Twp. 2.81 CH. (185.46') North" 16" W. Oak S. 20°-30' W. 47.52'

1956 - W.Q. Smith, C.S.  
Finds Standard Brass Section Corner Marker as relocated from quarter posts of Sections 1 and 12.

B. Description of corner evidence found and/or method applied in restoring or reestablishing corner:

Found Standard Brass cap Section corner marker was approved and authorized by the Van Buren County Remonumentation Peer Group, said Peer Group decided to retain "Standard Brass Cap" as permanent corner.


Ratified by Peer Group in accordance with P.A. 345 of 1990  
Van Buren County Surveyor

Date 12/21/94 *DRG*

C. Description of monument for corner and accessories established to perpetuate locating the position of the corner:

Found Standard Brass Cap Section Corner Marker is accepted as a careful and faithful reestablishment of the original corner. Set monument box over.  
Accessories:

- Nail & Tab in 36" Oak N. 30° W. 33.55'
- Nail & Tab in 12" Oak N. 6° E. 21.70'
- Nail & Tab in 20" Twin Oak S. 11° E. 37.09'
- Nail & Tab in 20" Oak WEST 29.18'

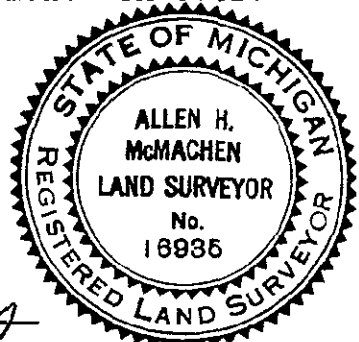

Signed by *Allen H. McMachen* Date 12/21/94  
Surveyor's Michigan License No. 16935