

**SURVEY & REMONUMENTATION**

JAN 11 1999

**FILED**  
DEC 21 4 10 PM '98

**LAND CORNER RECORDATION CERTIFICATE**  
Filing Requirement of Act 74, Mich. P.A. 1970

**SECTION**

For corners in

*Mark A. Smith*  
VAN BUREN CO.  
REGISTER OF DEEDS

VAN BUREN Located In: Corner Code #  
(County) S.E. Corner, Section 13, Antwerp Twp.

- 1. Public Land Survey T 3 s R 13 w M-7  
T \_\_\_\_\_ R \_\_\_\_\_  
T \_\_\_\_\_ R \_\_\_\_\_  
T \_\_\_\_\_ R \_\_\_\_\_
- 2. Property Controlling S \_\_\_\_\_ T \_\_\_\_\_ R \_\_\_\_\_  
in Section S \_\_\_\_\_ T \_\_\_\_\_ R \_\_\_\_\_
- 3. Miscellaneous S \_\_\_\_\_ T \_\_\_\_\_ R \_\_\_\_\_  
Property in Sec. S \_\_\_\_\_ T \_\_\_\_\_ R \_\_\_\_\_

*Liber 5 pg 190*

**Register of Deeds Stamp & File Number**

- 4. Lot No. \_\_\_\_\_, Recorded Plat \_\_\_\_\_
- 5. Private Claims \_\_\_\_\_

I, James E. Boynton, in a field survey on March 27, 1998 do hereby certify that under requirements of P.A. 74, Michigan P.A. of 1970, the corner points mentioned in lines 1 and 2 above were in conformance with regulations and rules therefore as required in the current manual of survey instructions of the United States Department of the Interior, Bureau of Land Management or by a decree of a Court of Law and /or that the corner points mentioned in lines 3, 4 and 5 above were in conformance with the rules of the Michigan Board of Land Surveyors or by a Decree of a Court of Law; established, re-established, monumented, re-monumented, recovered, found as expressed below:

	A	B	C	D	E	F	G	H	I	J	K	L	M
1													
2	6		5		4		3		2		1		
3													
4	7		8		9		10		11		12		
5													
6	18		17		16		15		14		13		
7													
8	19		20		21		22		23		24		
9													
10	30		29		28		27		26		25		
11													
12	31		32		33		34		35		36		
13													

**NOTE: Not more than 4 corners, all in the same town and range, may be recorded on this certificate.**

A. Description of original monument and accessories and/or subsequent restoration:


Original corner location established in 1827 by William Brookfield, D.S. In 1869 F. Hodgman, Kalamazoo C. S. found and used corner to re-establish the Kalamazoo corner. In 1913 W. H. Goss found and referenced a 1" pipe. This pipe was found, used and referenced many times thru 1990.

B. Description of corner evidence found and/or method applied in restoring or reestablishing corner:

Found a 1" pipe from 1990 references and accepted as the best available evidence of the corner.

C. Description of monument for corner and accessories established to perpetuate locating the position of the corner:

Set standard monument in position of pipe as directed by the Remonumentation Peer Group on March 25, 1998.  
Triple Ironwood S.10° W. 26.41' to nail  
10" Ironwood S.85° W. 27.31' to nail  
Found iron bar by J. Hunt 34.89' West  
6" tree N.05° W. 6.95' to nail  
Found stone with chiseled + 131.68' North (Kalamazoo corner)

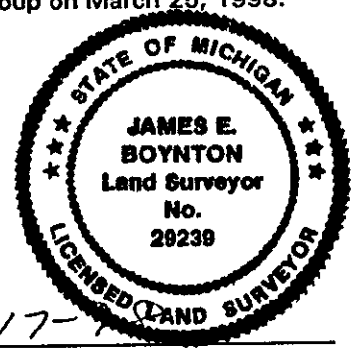

Signed by James E. Boynton Date 12-17-98  
Surveyor's Michigan License No. 29239

Ratified by Peer Group in accordance with P.A. 345 of 1990  
Van Buren County Surveyor  
Date D.R.A. 12-21-98