

JAN 17 1996

DEC 22 9 29 AM '94

COMMISSION

LAND CORNER RECORDATION CERTIFICATE  
Filing Requirement of Act 74, Mich. P.A. 1970

For corners in

Van Buren  
(County)

S.E. COR.  
SEC. 36

Located in: Antwerp

Corner Code #

1. Public Land Survey

T 3 S R 13 W

M-13 ✓

T \_\_\_ R \_\_\_

T \_\_\_ R \_\_\_

T 35 R 13 W

M-01

2. Property Controlling in Section

S \_\_\_ T \_\_\_ R \_\_\_

S \_\_\_ T \_\_\_ R \_\_\_

3. Miscellaneous Property in Sec.

S \_\_\_ T \_\_\_ R \_\_\_

S \_\_\_ T \_\_\_ R \_\_\_

4. Lot No. \_\_\_\_\_, Recorded Plat \_\_\_\_\_

5. Private Claims \_\_\_\_\_

*Mark A. Smith*  
VAN BUREN CO.  
REGISTER OF DEEDS

LIBER 4 PAGE 238

Register of Deeds Stamp & File Number

7-00  
1242 0101 10SURVEY

I, James E. Boynton, in a field survey on July 1, 19 94, do hereby certify that under requirements of P.A. 74, Michigan P.A. of 1970, the corner points mentioned in lines 1 and 2 above were in conformance with regulations and rules therefore as required in the current manual of survey instructions of the United States Department of the Interior, Bureau of Land Management or by a decree of a Court of Law and/or that the corner points mentioned in lines 3, 4 and 5 above were in conformance with the rules of the Michigan Board of Land Surveyors or by a Decree of a Court of Law; established, re-established, monumented, re-monumented, recovered, found as expressed below:

NOTE: Not more than 4 corners, all in the same town and range, may be recorded on this certificate.

	A	B	C	D	E	F	G	H	I	J	K	L	M
2	6	5	4	3	2	1							
3													
4	7	8	9	10	11	12							
5													
6	18	17	16	15	14	13							
7													
8	19	20	21	22	23	24							
9													
10	30	29	28	27	26	25							
11													
12	31	32	33	34	35	36							
13													

A. Description of original monument and accessories and/or subsequent restoration:

Original corner established in 1827 by William Brookfield, D.S. - not found  
W.H. Goss, C.S. found large stone in 1900.  
W.Q. Smith, C.S. set pipe over stone in 1958.  
G. Mitchell, P.S. shows rebar in mon. box in 1992.

B. Description of corner evidence found and/or method applied in restoring or reestablishing corner:

Found iron, pipe and stone from witnesses. Accepted as best evidence of original corner.


Ratified by Peer Group in accordance with P.A. 345 of 1998  
Van Buren County Surveyor

Date D. R. A. 12/20/94

C. Description of monument for corner and accessories established to perpetuate locating the position of the corner:

set standard marker in place of iron, pipe and stone as directed by Peer Group on June 29, 1994.

T.C.B. N.45°W. 48.74' to G  
20" Walnut East 39.15' to nail.  
9" Walnut N.35°E. 49.58' to nail.  
Twin 9" Walnut S.50°E. 52.05' to nail.

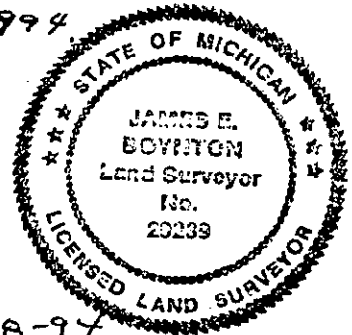

Signed by James E. Boynton

Date 12-18-94

Surveyor's Michigan License No. 29239