

FILED

Dec 10 4 45 PM '99

LAND CORNER RECORDATION CERTIFICATE
Filing Requirement of Act 74, Mich. P.A. 1970

REGISTERED PROFESSIONAL SURVEYOR
No. 13583

7-00

For corners in Paw Paw Township

Van Buren County (County)	Located In:	Corner Code #
1. Public Land Survey	T ___ R ___	#001
	T ___ R ___	_____
	T ___ R ___	_____
	T ___ R ___	_____
2. Property Controlling in Section	S 30 T 3S R 14W	_____
	S ___ T ___ R ___	_____
3. Miscellaneous Property in Sec.	S ___ T ___ R ___	_____
	S ___ T ___ R ___	_____

LIBER 5 PAGE 247

857 12/10 0101 10SURVEY

Register of Deeds Stamp & File Number

4. Lot No. _____, Recorded Plat _____
5. Private Claims _____

I, Donald R. Gilchrist in a field survey on Dec. 7, 19 99 do hereby state that under requirements of P.A. 74, Michigan P.A. of 1970, the corner points mentioned in lines 1 and 2 above were in conformance with regulations and rules therefore as required in the current manual of survey instructions of the United States Department of the Interior, Bureau of Land Management or by a decree of a Court of Law and /or that the corner points mentioned in lines 3, 4 and 5 above were in conformance with the rules of the Michigan Board of Land Surveyors or by a Decree of a Court of Law, established, re-established, monumented, recovered, found as expressed below:

NOTE: Not more than 2 corners, all in the same town and range, may be recorded on this certificate.

	A	B	C	D	E	F	G	H	I	J	K	L	M
1													
2	6		5		4		3		2		1		
3													
4	7		8		9		10		11		12		
5													
6	18		17		16		15		14		13		
7													
8	19		20		21		22		23		24		
9													
10	30		29		28		27		26		25		
11													
12	31		32		33		34		35		36		
13													

A. Description of original monument and accessories and/or subsequent restoration:

Set in intersection point with Harrison Marker in Monument Box.
No history.

Ratified by Peer Group in accordance with P.A. 345 of 1990
Van Buren County Surveyor
Date 12-10-99 D. R. G.

B. Description of corner evidence found and/or method applied in restoring or reestablishing corner:


Set point at the intersection of South line of Section 30 and Paw Paw & Lawrence Town Line 17.82' West of Paw Paw corner.
Approved at the 7/28/99 meeting of the Van Buren County Peer Group

SURVEY & RECONSTRUCTION

DEC 28 1999

C. Description of monument for corner and accessories established to perpetuate locating the position of the corner:

8" Willow - N 45° W - 42.70' - N/W E. side.
20" Walnut - S 40° W - 44.61' - N/W E. side.
Monument S.W. Corner, Section 30 - East - 17.82'.
R.R. Fence Post - East - 31.27'.
4' East Centerline Road.

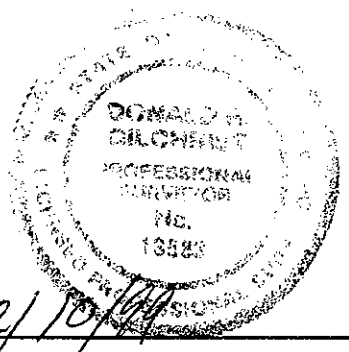

Signed by Donald R. Gilchrist
Surveyor's Michigan License No. RLS 13583

Date 12/10/99