

LAND CORNER RECORDATION CERTIFICATE
Filing Requirement of Act 74, Mich. P.A. 1970

For corners in

Town Range
 (County)

Located In:

Corner Code //

1. Public Land Survey

T. 35 R. 4
 T. 35 R. 4
 T. R.
 T. R.

A6
A7

2. Property Controlling in Section

S. T. R.
 S. T. R.

3. Miscellaneous Property in Sec.

S. T. R.
 S. T. R.

Register of Deeds Stamp & File Number

4. Lot No.

Recorded Plat

5. Private Claims

	A	B	C	D	E	F	G	H	I	J	K	L	M
2	6	5	4	3	2								
3													
4	7	8	9	10	11	12							
5													
6	13	17	16	15	14	13							
7													
8	19	20	21	22	23	24							
9													
10	30	29	28	27	26	25							
11													
12	31	32	33	34	35	36							
13													

I, Cary C. Bilow, in a field survey on _____, 19____, do hereby certify that under requirements of P.A. 74, Michigan P.A. of 1970, the corner points mentioned in lines 1 and 2 above were in conformance with regulations and rules therefore as required in the current manual of survey instructions of the United States Department of the Interior, Bureau of Land Management or by a decree of a Court of Law and/or that the corner points mentioned in lines 3, 4 and 5 above were in conformance with the rules of the Michigan Board of Land Surveyors or by a Decree of a Court of Law, established, re-established, monumented, re-monumented, recovered, found as expressed below.

NOTE: Not more than 4 corners, all in the same town and range, may be recorded on this certificate.

A. Description of original monument and accessories and/or subsequent restoration:

A6: Post not established by U.S. Gov't survey. County Surveyor I.A. Smith records in 1924 State Land Stone - Substrat 11, 11.11' Maple 24, S50W 59.6'. Corner recorded under Act 74, P.A. 1970 by Allen H. McMicken in Liber 1 Page 592 on 11/15/1970 as "Found 1/2" iron rod - accessories: 15" tree, S45E 54.0'; Pole, N50E 57.0'; Sign, N30W 213.25'."

A7: Post established by U.S. Deputy Surveyor W. Brown in 1850 as "Intersected West boundary 0.77 links North of Post - set corner to 13 & 19" - accessories: White Oak 24, S43E 39 links; White Oak 16, N14E 37 links." Corner recorded under Act 74, P.A. 1970 by Gilchrist (L.S. 110583) in Liber 1 Page 572 on 11/17/1972 as "Found railroad spike down 4' at centerline road - accessories: 30" Oak N35E 20.04'; 10" Hickory, N30W 24.69'; 16" Oak, S80W 19.83'." Corner recorded by D. Brock in Liber 1 Page 26 on 10/29/1974 as "Found railroad spike over 1/2" iron pipe 1' west of centerline of 46th St. - pulled railroad spike and placed permanent box around 1/2" iron pipe - accessories: N45W 24.77'; 12" Hickory; S65W 19.96'; 17" Oak; S20W 55.31'; 21" Oak."

B. Description of corner evidence found and/or method applied in restoring or reestablishing corner:


A6: Found 1/2" iron rod in Monument box and none of A. McMicken's accessories. Corner shown on several recorded surveys as being 350.61' North of 1st. T.S. R15W - distance between corners measured 360.64'. Accepted corner.

A7: Found 1/2" iron pipe in Monument box and three (3) of Houth's accessories. Accepted corner as the best exposure of the original 6.0 post.

C. Description of monument for corner and accessories established to perpetuate locating the position of the corner:

A6: Found 1/2" iron rod in Monument box S22W 111.81', N87' in Southeast face of 6" Oak
 N27E 34.76', 31' in Southeast face of 6" Juniper
 S17E 75.42', 31' in West face of 15" Oak
 North 2.35', 1/2" rod in Mon. Box

A7: Found 1/2" iron pipe in Monument box 1.5' west of centerline 46th St
 N17W 24.07', N87' in southwest face of 12" Hickory
 S10W 15.92', N51' in North face of 20" Oak
 S36W 54.84', 38' in Northwest face of 24" Oak
 N33W 37.95', N61' in Northeast face of 16" Oak

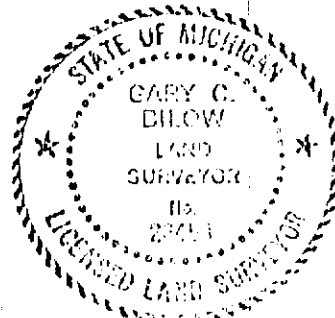

Signed by

Cary C. Bilow

Date

9/6/82