

LAND CORNER RECORDATION CERTIFICATE

FILING REQUIREMENT OF ACT 74, MICH. P.A.1970

DEC 17 9 27 AM '98

SW CORNER SEC. 5 T3S R14W PAW PAW TWP.

Mark A Smith
VAN BUREN CO
REGISTER OF DEEDS

FOR CORNERS OF--:	LOCATED IN--:	CORNER CODE NUMBER
1. PUBLIC LAND SURVEY _____	T. <u>3</u> ^{XX} S., R. <u>14</u> ^{XX} W.	<u>C-3</u>
2. PROPERTY CONTROLLING IN SECTION _____	, T. _____ N. S., R. _____ E. W.	_____
3. MISCELLANEOUS PROPERTY IN SECTION _____	, T. _____ N. S., R. _____ E. W.	_____
4. LOT NO. _____, RECORDED PLAT _____		
5. PRIVATE CLAIMS _____		

LIBER 5 PAGE 184

REGISTER OF DEEDS STAMP AND FILING NUMBER

9-00
3395 12/17 0101 10SURVEY

I, CHARLES D. LOSSIE, do hereby certify that under requirements of P.A. 74, Michigan P.A. of 1970, the corner points mentioned in lines 1 and 2 above were, in a field survey on 12/14, 1998, established, re-established, monumented, re-monumented, recovered or restored as expressed below and in conformance with regulations and rules therefore as required in the current manual of survey instructions of the United States Department of the Interior, Bureau of Land Management or by a decree of a court of law. Furthermore, that the corner points mentioned in lines 3, 4 and 5 above were, in a field survey on _____, 19____, found, recovered, restored, established or re-established as expressed below and in conformance with the rules of the Michigan State Board of Registration for Land Surveyors or, by a Decree of a Court of law:

A. Description of original monument and accessories and/or subsequent restoration:

SEE BACK SHEET

SURVEY & REMONUMENTATION

JAN 11 1999

SECTION

Retified by Peer Group in accordance with P.A. 345 of 1990
Van Buren County Surveyor

Date D. R. A. 12-17-98

B. Description of corner evidence found and/or method applied in restoring or re-establishing corner:


FOUND 1/2" IRON AND MONUMENT BOX. SET BY W.Q. SMITH IN 1969. THE FOUND 1/2" IRON WAS ACCEPTED AS BEST AVAILABLE EVIDENCE AS THE POSITION OF THE ORIGINAL CORNER AT A PEER GROUP MEETING HELD 12/9/98.

C. Description of monument for corner and accessories established to perpetuate locating the position of the corner:

TIED OFF 1/2" IRON. SET HARRISON MARKER.
SOUTH END POST OF SECOND ROW OF GRAPES S.80° E. 44.65' TO PK AND WASHER.
SOUTH END POST OF FIRST ROW OF GRAPES S.30° W. 122.17' TO PK AND WASHER.
8TH POST NORTH ON FIRST ROW OF GRAPES N.45° W. 37.52' TO PK AND WASHER.
3RD POST NORTH ON FIRST ROW OF GRAPES N.50° E. 50.61' TO PK AND WASHER.

SIGNED BY Charles D. Lossie DATE _____

SURVEYOR'S MICHIGAN REGISTRATION NO. 44291

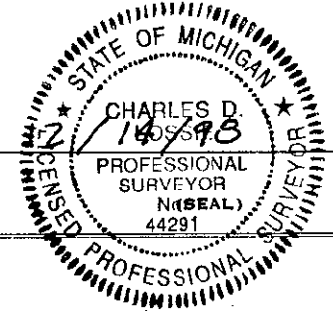

FOR STATE AND UNITED STATES AGENCIES:

SIGNED BY _____ DATE _____
CHIEF OF SURVEY PARTY

APPROVED AND SIGNED BY _____ DATE _____
MICHIGAN REGISTERED LAND SURVEYOR (SEAL)

SURVEYOR'S MICHIGAN REGISTRATION NO. _____

**SOUTHWEST CORNER OF SECTION 5
TOWN 3 SOUTH, RANGE 14 WEST, PAW PAW TWP. (C-3).**

5/1830- GOVERNMENT - William Brookfield, D.S.

Ran North between sections 7 & 8 a distance of 80.00 chs. (5280.00') and set a post corner

WITNESSES: 20" Yellow Oak - N. 22° E. 19 lks. (12.54').
20' Yellow Oak - S. 19° W. 37 lks. (24.42').

Distance West is 70.65 chs. (4662.9').

Distance East is 79.43 chs. (5242.38').

2/14/1903 - W. H. Goss, C.S.

Section 5. Book 5- Page 55 & Book 1 - Page 134

Red Book & Goss Notes.

Found pile of stones for corner - set stake.

WITNESSES: 24" Black Oak - S. 2° 45' E. - 392 lks. (258.72')

Distance North is 40.18 chs. (2651.80').

Distance West is 39.98 chs. (2638.68').

8/6/1969 & 8/8/1969- COUNTY SURVEYOR REFERENCE CARD & Smith & Smith, Inc.

Recordation Certificate (Liber 1 - Page 118).

Set iron by old distances and occupation.

WITNESSES: 6" Pear - N. 50° W. - 27.27'

6" Pear - S. 60° W. - 25.03'.

Post at South end of grape vineyard - N. 80° E. - 44.18'.

Iron in centerline North & South Road.

6" Oak - S. 10° E. - 93.15'.

3/20/1974- W.Q. Smith, C.S.

Section 6. Survey Drawing - (Liber 5- Page 46). Survey shows corner.

Distance West is 2644.09'.

Distance North is 1323.89' to Eighth Post, and continuing North 1323.89' to Quarter Post for a total 2647.78'.

6/26/1980- J.C. Hunt, R.L.S.

Section 5. Survey shows corner.

Distance East is 2638.03'.

Distance North is 1323.89' to Eighth Post, and continuing North 1323.89' to Quarter Post for a total of 2647.78'.

**SURVEY &
REMONUMENTATION**

JAN 11 1999

SECTION