

LAND CORNER RECORDATION CERTIFICATE
 Filing Requirement of Act 74, Mich. P.A. 1970

FILED

For corners in Paw Paw Township

Van Buren Located In: Corner Code #
 (County)

1. Public Land Survey T3S R14W G5
 SW Corner, Sec 10
 T___ R___
 T___ R___
 T___ R___

2. Property Controlling S___ T___ R___
 in Section S___ T___ R___
 3. Miscellaneous S___ T___ R___
 Property in Sec. S___ T___ R___

Oct 30 10 39 AM '98
Mark A. Smith
 VAN BUREN CO.
 REGISTER OF DEEDS
 Liber 5 PAGE 106
 Register of Deeds Stamp & File Number

4. Lot No. _____, Recorded Plat _____
 5. Private Claims _____

I, Donald R. Gilchrist in a field survey on May 6, 1998 do hereby state that under requirements of P.A. 74, Michigan P.A. of 1970, the corner points mentioned in lines 1 and 2 above were in conformance with regulations and rules therefore as required in the current manual of survey instructions of the United States Department of the Interior, Bureau of Land Management or by a decree of a Court of Law and /or that the corner points mentioned in lines 3, 4 and 5 above were in conformance with the rules of the Michigan Board of Land Surveyors or by a Decree of a Court of Law, established, re-established, monumented, recovered, found as expressed below:

NOTE: Not more than 2 corners, all in the same town and range, may be recorded on this certificate.

A	B	C	D	E	F	G	H	I	J	K	L	M
1												
2	6	5	4	3	2	1						
3												
4	7	8	9	10	11	12						
5												
6	18	17	16	15	14	13						
7												
8	19	20	21	22	23	24						
9												
10	30	29	28	27	26	25						
11												
12	31	32	33	34	35	36						
13												

A. Description of original monument and accessories and/or subsequent restoration:

4/1830 - GOVERNMENT - William Brookfield, D.S.
 Ran North between Sections 15 and 16 a distance of 80.00 chs. (5280.00') and set post corner.
 Witnesses:
 10" White Oak - S 1/4 E - 119.7 lks. (79.00').
 No other bearing tree near.

**SURVEY &
 REMONUMENTATION**

JAN 11 1999

(Continued on back of Certificate)

SECTION

B. Description of corner evidence found and/or method applied in restoring or reestablishing corner:

Found piece of Cedar post - 0.80' West of galvanized metal sign post (as used by Road Commission). Found 1/2" iron used for corner in past S 66° E - 17.25'. Distance South is 2655.86'. T.A. Smith. Distance is 2656'. Line is straight though old surveys South of Red Arrow.
 Approved at the 8/26/98 Van Buren County Peer Group Meeting and is accepted as best available evidence.


C. Description of monument for corner and accessories established to perpetuate locating the position of the corner:

Set Harrison Marker in place of Cedar post.
 12" Oak - N 1° 30' W - 79.65' - N/W in West side.
 16" Twin Willow - S 80° E - 36.36' N/W in North side.
 15" Quad Maple - S 25° E - 39.07' N/W in West side.
 Found 1/2" iron (has been used as corner) S 66° E - 17.25'
 Galvanized metal sign post - East - 0.80'

Ratified by Peer Group in accordance with P.A. 345 of 1990
 Van Buren County Surveyor

Date D.R.G. 10-30-98

Signed by Donald R. Gilchrist
 Surveyor's Michigan License No. RLS 13583

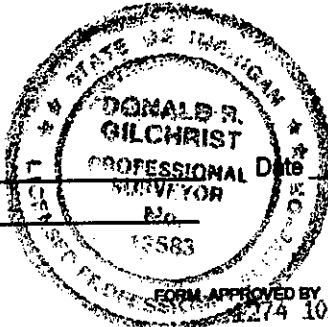

10/21/98

3/28/1871 - A. J. Pierce, C.S.

Section 10

Section corner in swamp - set by Blackman - didn't go to it.

Red Book - Shows distance East of 39.735 chs. (2622.51').

Distance North is 20.25 chs. (1321.65') and continuing 1321.65' for a total of 2643.30'.

4/30/1934 - T. A. Smith, C.S. (Affidavit).

Sections 15 & 16.

Drawing shows Lillian M. Jorgensen's farm on both sides of the section line. The distance to Red Arrow is 1366' and the angle to centerline of Red Arrow is $79^{\circ} 9'$.

5/23/1939 - Drawing and Notes - Shows section line and distance North from Quarter Post of 1290.00' to centerline of Red Arrow and angle is $100^{\circ} 51'$.

11/21/1949 - Note - Section 9 - Distance North to Quarter Post is 2641.00'.

5/31/1956 - W. Q. Smith, C.S.

Section 15

Notes & Drawing show corner and a pipe 194' East, and continuing 294.64' to pipe for a total of 488.64'.

8/27/1964 Note, and Note dated 11/26/1968 shows corner.

Section 16

10/7/1971 - Recorded Survey (Liber 1 - Page 131).

Shows distance West of 1332.68' and continuing 1332.68' to North Quarter Post for a total of 2665.36'.

5/12/1972 - D. A. Middleton, R.L.S. (Smith & Smith, Inc.)

Section 16

Recorded Survey (Liber 2 - Page 277) shows corner.

Recordation Certificate (Liber 1 - Page 476).

Note - States set 1/2" iron bar - could find no evidence of old corner. Corner was reestablished from old survey tied to the corner when corner existed.

Witnesses:

30" Triple Willow - East - 20.76' to nail.

30" Willow Stump - S $75^{\circ} W$ - 18.10' to nail.

Fence Corner (Fence North & West) - N $70^{\circ} W$ - 16.82' to nail.

8/5/1975 - A. H. McMachen, R.L.S.

Section 15

Recorded Survey (Liber 5 - Page 308).

Shows distance of 488.64' to 1/2" iron in monument box.

Witnesses:

Fence corner - N $70^{\circ} W$ - 16.52'.

Tri. Willow - East - 20.76'

30" Willow Stump - S $75^{\circ} W$ - 18.1'.

5/7/1986 - D. R. Gilchrist, C.S.

Section 16

Drawing shows corner as iron.

Witnesses:

Fence Corner - N $70^{\circ} W$ - 16.82'.

Willow - East - 20.76'

30" Willow Stump - Westerly - 18.1'.

Distance South is 2655.86'.

Distance West is 2665.36'.

9/11/1989 - Drawing shows distance from East Quarter Post to centerline of Red Arrow Highway as 1294.69'.

7/16/1997 - Drawing shows distance East as 1304.60' to Eighth Post.

8/19/1998 - Section 15

Drawing shows corner (placed iron rod).

Witnesses:

Nail & tag West side 12" Oak - N $1^{\circ} 30' W$ - 79.65'.

Nail & tag North side 16" Twin Willow - S $80^{\circ} E$ - 36.36'.

Found iron rod (has been used for section corner) - S $66^{\circ} E$ 17.25'.

Nail & tag West side 15" Quad. Maple - S $25^{\circ} E$ - 39.07'.

Galvanized metal sign post (as used by Road Comm.) - E - 0.80'.

Found cedar post.

T. A. Smith's distance South is 2656.00'.

Computed distance South is 2655.86'.