

SURVEY & REMONUMENTATION

JUN 29 1995

VAN BUREN COUNTY REMONUMENTATION PROGRAM

COMMISSION

LAND CORNER RECORDATION CERTIFICATE

FILED

For corners in PAW PAW TWP.

Corner Common to Sections 15, 16, 21, & 22.

VAN BUREN (County)	Located In:	Corner Code ==
1. Public Land Survey Sec. 22 NW corner	T 3 S. R 14 W. T _____ R _____ T _____ R _____ T _____ R _____	G-7
2. Property Controlling in Section	S _____ T _____ R _____ S _____ T _____ R _____	
3. Miscellaneous Property in Sec.	S _____ T _____ R _____ S _____ T _____ R _____	

JUN 13 4 15 PM '95

Mark A. Smith
VAN BUREN CO.
REGISTER OF DEEDS

Liber 4 Page 288

Register of Deeds Stamp & File Number

4. Lot No. _____, Recorded Plat _____
5. Private Claims _____

	A	B	C	D	E	F	G	H	I	J	K	L	M
2	6	5	4	3	2	1							
3													
4	7	8	9	10	11	12							
5													
6	10	17	16	15	14	13							
7													
8	19	20	21	22	23	24							
9													
10	30	29	28	27	26	25							
11													
12	31	32	33	34	35	36							
13													

I, John C. Hunt, P.S., in a field survey on Feb. 16, 1995, do hereby certify that under requirements of P.A. 74, Michigan P.A. of 1970, the corner points mentioned in lines 1 and 2 above were in conformance with regulations and rules therefore as required in the current manual of survey instructions of the United States Department of the Interior, Bureau of Land Management or by a decree of a Court of Law and/or that the corner points mentioned in lines 3, 4 and 5 above were in conformance with the rules of the Michigan Board of Land Surveyors or by a Decree of a Court of Law; established, re-established, monumented, re-monumented, recovered, found as expressed below:

NOTE: Not more than 4 corners, all in the same town and range, may be recorded on this certificate.

A. Description of original monument and accessories and/or subsequent restoration:

G-7 5/11/1830 Gov.: Wm. Brookfield DS; Surveyed N. bet. Sec. 21 & 22 80.00 chs, (5280') & set Post sec. corner; wit.: 14" W. Oak S18°15'E 26.40', 16" W. Oak S22°30'W 40.92'. 3/30/1871 AJ Pierce CS: Sec. 21: "Sec. cor. gone, cor. is 10+ lks (6.60') W. of Blackman's cor. & 5' or 6' N. of Line. Distance W. to N $\frac{1}{4}$ post 2645.28', dist. S. 887.7' & cont. S. 1749.33' to E $\frac{1}{4}$ Post, total 2637.03'. Red Ek. "Established". Wit.: 6" Walnut S82°30'E 31.02', 6" W. Oak N87°30'W 33.66'. No Date Red Ek., maybe Ackley? (Sec. 15) Iron Pipe. Wit.: 8" B.Wal. S82°15'E 31.18', 10" Pine Nut S50°E 42.57', 1" Sugar N51°30'E 24.09'. Dist. N. to $\frac{1}{4}$ Post 2643.30'. Dist. E. 2622.51' to $\frac{1}{4}$ Post & 2622.51' to SE cor., total 5245.02'. 5/21/1932 TA Smith CS: Dist. W. to W $\frac{1}{4}$ Post 2652.50', dist. S. to S $\frac{1}{4}$ Post, total 2643.36'. 4/1959 MDOT ROW Ek.: Dist. N. to C/L I-94 Hiwy 1471.48' & cont. N. to $\frac{1}{4}$ post 1171.70, total 2643.18'. 5/18/1972 WQ Smith CS: LCRC L.1 p.442: Ed. $\frac{1}{2}$ " pipe w/ flat stone on top of it & witnessed. 11/9/1990 JC Hunt PS: Sec. 21 survey shows cor. & dist. W to N $\frac{1}{4}$ Post 2651.65'. 9/7/1993 Survey shows cor. & wit.: $\frac{1}{2}$ " iron inside a 1" pipe & witnesses. Distance S. to E $\frac{1}{4}$ Post is 2643.21'.

B. Description of corner evidence found and/or method applied in restoring or reestablishing corner:


G-7 Northwest Corner Sec. 22, T3S-R14W Paw Paw Twp.
Found 3/4" iron pipe inside 1 $\frac{1}{2}$ " iron pipe (Top 3/4" I.P. bent—held 1 $\frac{1}{2}$ " I.P. 12" below surface). Corner is 1' South of centerline of road to West & 6' W. of centerline of road North & South, in line with brush row to East.
Also found small stones & broken crockery around 1 $\frac{1}{2}$ " iron pipe.
Removed 3/4" & 1 $\frac{1}{2}$ " iron pipes & set Harrison Marker 6" below gravel road surface.

Retified by Peer Group in accordance with P.A. 345 of 1990
Van Buren County Surveyor
Date J. P. S. R.R.H.

C. Description of monument for corner and accessories established to perpetuate locating the position of the corner:

G-7 HARRISON MARKER

- S.32°W. 44.68' Set PK nail & washer in NW face of 26" Oak.
- S.76°W. 68.77' Found nail & washer in N. face of 24" Oak.
- N.86°E. 29.85' Found nail in N. face of 10" Wild Cherry.
- N.55°E. 36.09' Set PK nail & washer in NW face of 5" Oak.

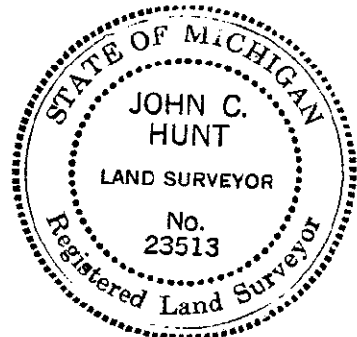

Signed by John C. Hunt, P.S. Date Feb. 17, 1995
Surveyor's Michigan License No. 23513