

Dec 1 9 28 AM '99

LAND CORNER RECORDATION CERTIFICATE

FILING REQUIREMENTS OF ACT 74, MICH. P.A. 1970

Mark A. Smith  
VAN BUREN CO  
REGISTER OF DEEDS

9.00  
8190 12/01 0104 10SLURVEY

West 1/4 Post, Section 22 Paw Paw Township

FOR CORNERS OF:	LOCATED IN:	CORNER CODE NUMBER
1. PUBLIC LAND SURVEY	T. 3 S., R. 14 W.	G-8
2. PROPERTY CONTROLLING IN SECTION	T. N. S., R. E. W.	
3. MISCELLANEOUS PROPERTY IN SECTION	T. N. S., R. E. W.	DEC 28 1999
4. LOT NO.	RECORDED PLAT	SECTION
5. PRIVATE CLAIMS		

REGISTER OF DEEDS STAMP AND FILING NUMBER

I, Charles D. Lossie, P.S., in a field survey on 18-Oct, 19 99 do hereby state that under requirements of P.A. 74, Michigan P.A. of 1970, the corner points mentioned in lines 1 and 2 above were in conformance with regulations and rules, therefore as required in the current manual of survey instructions of the United States Department of the Interior, Bureau of Land Management or by a decree of a Court of Law and/or that the corner points mentioned in lines 3, 4 and 5 above were in conformance with the rules of the Michigan Board of Land Surveyors or by a Decree of a Court of Law; established, re-established, monumented, recovered, found as expressed below:

NOTE: Not More than 2 corners, all in the same town and range may be recorded on this certificate.

A	B	C	D	E	F	G	H	I	J	K	L	M
1												
2	6	5		4		3		2		1		
3												
4	7		8		9		10		11		12	
5												
6	18		17		16		15		14		13	
7												
8	19		20		21	22		23		24		
9												
10	30		29		28		27		26		25	
11												
12	31		32		33		34		35		36	
13												

A. Description of original monument and accessories and/or subsequent restoration:  
**1830- GOVERNMENT - William Brookfield, D.S.**

Ran North between Sections 21 and 22 a distance of 40.00 chs. (2640.00') and set Quarter Section Post

Witnesses:

14" White Oak - S. 18°E., - 40 lks (26.40')

16" White Oak - S. 22° , 30' W., - 652 lks (40.92')

See Back for Additional Corner History

B. Description of corner evidence found and/or method applied in restoring or re-establishing corner:

Found Harrison Marker, old witnesses, did not check, dug out and set Harrison Marker at the intersection of the witnesses.

This Government Monument was restored with the approval of the Van Buren County Remonumentation Peer Group of Surveyor's on September 1, 1999 as a careful and faithful perpetuation of the position of the original corners.

C. Description of monument for corner and accessories established to perpetuate locating the position of the corner:

Harrison Marker

10" Cherry, East 30.20' to PK and Washer

10" Cedar, S. 28° E., 82.74' to PK and Washer

30" Oak, S. 30° W., 44.65' to PK and Washer

30" Oak, S. 80°, 68.53' to PK and Washer


Ratified by Peer Group in accordance with P.A. 345 of 1990  
Van Buren County Surveyor

Date 12-1-99 D. R. A.

Signed by Charles D. Lossie P.S.

Charles D. Lossie, P.S.

Surveyor's Michigan License No. 44291

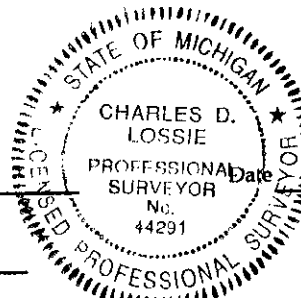

Letter 5 pg 241

West 1/4 Post, Section 22 Paw Paw Township

3/30/1871 - A. J. Pierce, C.S.

Section 21  
Book 4 - Page 57  
One Tree remains and one stump - corner preset.  
Distance North is 39.955 chs. (2637.03').

RECORDED SURVEY A

1900 ± - W. H. Goss, C. S. (?)

Section 21  
Red Book  
Pipe  
*Witnesses:*  
12" Hickory - Southwest - 226.5 lks. (149.49').  
3" Black Oak - Southwest - 105 lks. (69.30').

DEC 28 1999

SECTION

2/10/1930 - T. A Smith, C.S.

Section 21  
Drawing states Quarter Post East 1181.4' from East line of parcel on lake.  
8/3/1946 - Drawing states Quarter Post East 1934.4'.  
8/23/1947 - Drawing states Quarter Post East 1934.4'.

12/5/1966 - W. Q. Smith, C.S.

Section 21  
Drawing shows same as above.

9/27/1968 - Elmer Stefan, R.L.S.

Section 22  
Found Corner  
Distance South is 2644.00'.  
Treatment Plant Survey - Distance North is 1321.67' and continuing North 1321.67' for a total of 2643.34'.

1/1972 - W. Q. Smith, C.S. /D. A. Middleton, R.L.S.

West Quarter Post, Section 22 - Distance East is 1312.17' and continuing East 1312.17' for a total of 2624.34'.

5/18/1972 - Recordation Certificate (Liber 1 - Page 444).

Pipe

*Witnesses:*

Corner is 6' ± West of centerline of North and South road.  
24" Oak - West - Southwest - 68.70 to tack and washer in North side.  
Phone Pedestal - East - 32.27' to Centerline.

6/6/1983 - C. W. Glasner, R.L.S.

Section 21  
Recorded Survey (Liber 9 - Page 34).  
1" Pipe.

*Witnesses:*

20" Oak - S. 30° W., - 44.65'  
24" Oak - S. 20° W., - 68.60'  
8" Cherry - East - 30.08'.

POB is 2165.66' West and 186.48' South from East Quarter Post of Section 21.

9/14/1983 - J. C. Hunt, R.L.S.

Section 21  
Survey drawing shows corner  
12/27/1994 - Recorded Survey (Liber 10 - Page 151).  
Iron Pipe 6' West of Centerline of road North and South, and 2' South of Centerline of road to West and in line with brush row to East.

*Witnesses:*

East - 30.10' - Nail w/flagging on North face 10" Wild Cherry.  
S. 80° W., - 68.57' - Nail & Washer on North face, 25" Oak.  
S. 30° W., - 44.63' - Nail and tag on Northwest face of 27" Oak.  
S. 25° E., - 82.79' - Nail and tag on Northwest face of 10" Spruce.  
Easterly - 32.00' - to Centerline of telephone cable box.

4/17/1998 - Recorded Survey (Liber 11 - Page 99).

Found 3/4" iron pipe 6' West of Centerline of North and South road and in line with Centerline of road to West.

*Witnesses:*

N. 10° E., 70.00' - Centerline of steel post to dead sign.  
S. 75° W., -68.52' - Tack and Washer on West face of 24" Oak.  
East - 32.27' - Centerline of telephone ped.