

SURVEY &  
REMONUMENTATION

JUN 14 1994

COMMISSION

NE Corner

For corners in Paw Paw Twp.  
Van Buren County

LAND CORNER RECORDATION CERTIFICATE  
Filing Requirement of Act 74, Mich. P.A. 1970

(County)	Located in:	Corner Code #
1. Public Land Survey	S 28 T 3S R 14W	G9
	T _____ R _____	_____
	T _____ R _____	_____
	T _____ R _____	_____
2. Property Controlling in Section	S _____ T _____ R _____	_____
	S _____ T _____ R _____	_____
3. Miscellaneous Property in Sec.	S _____ T _____ R _____	_____
	S _____ T _____ R _____	_____

4. Lot No. \_\_\_\_\_, Recorded Plat \_\_\_\_\_  
5. Private Claims \_\_\_\_\_

I, DONALD R. GILCHRIST in a field survey on 3/30, 1993, do hereby certify that under requirements of P.A. 74, Michigan P.A. of 1970, the corner points mentioned in lines 1 and 2 above were in conformance with regulations and rules therefore as required in the current manual of survey instructions of the United States Department of the Interior, Bureau of Land Management or by a decree of a Court of Law and/or that the corner points mentioned in lines 3, 4 and 5 above were in conformance with the rules of the Michigan Board of Land Surveyors or by a Decree of a Court of Law; established, re-established, monumented, re-monumented, recovered, found as expressed below:

NOTE: Not more than 4 corners, all in the same town and range, may be recorded on this certificate.

A. Description of original monument and accessories and/or subsequent restoration:

See reverse side of page.

B. Description of corner evidence found and/or method applied in restoring or reestablishing corner:

Fd. 1" pipe & 1/2" iron 22.03' S 27° 32' 26" W. Dug on location of A.J. Pierce 10/1871 survey. Fd. pieces of brick, no stone. Brick checks S. for 1 mi., W to 1/4 P. & N to 1/4 P.  
S. from brick to 1/4 P. govt. = 2640/A.J.P. = 2650.56/DRG = 2649.69 cont. S to Sec. cor. govt. = 2640/A.J.P. = 2650.56/DRG = 2652.85 N. to 1/4 P. govt. 2640'/DRG 2654.71.  
W. to 1/4 P. govt. 2640.66/DRG = 2651.01'.  
Peer group approved to set marker on brick location of 2/24/93.

C. Description of monument for corner and accessories established to perpetuate locating the position of the corner:

Set Harrison marker.  
Marker to W. 1/4 p. of Sec 22 - bearing of N 0° 13' 15" E  
3/4" pipe was N. 0° 50' 17" W. - 11.30'  
1/2" iron was S. 51° 32' 58" W. - 13.20'  
P.P. - S. 50° E - 47.89' to nail NE side  
P.P. - N. 30° E - 89.34' to nail N side  
Cor. fen. post - N. 30° W - 51.75' to nail N side  
Q - Q 40th St. & Paw Paw Rd. - S 10° W - 60'±  
Q 40th St. 9' West  
Q Stop sign - S 55° W - 30.25 to Q

Signed by Donald R. Gilchrist  
Surveyor's Michigan License No. 13583

Date 4/1/1993

SURVEY &  
REMONUMENTATION

AUG 26 1993

COMMISSION

FILED


April 1  
MAR 32 11 21 AM '93

*Mark A. Smith*  
VAN BUREN CO  
REGISTER OF DEEDS

Register of Deeds Stamp & File Number

	A	B	C	D	E	F	G	H	I	J	K	L	M
2	6	5	4	3	2	1							
3													
4	7	8	9	10	11	12							
5													
6	18	17	16	15	14	13							
7													
8	19	20	21	22	23	24							
9													
10	30	29	28	27	26	25							
11													
12	31	32	33	34	35	36							
13													

*Filed 4 Page-1*

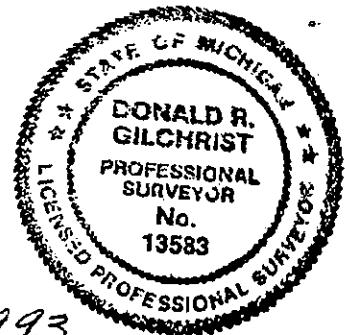

A. Description of original monument and accessories and/or subsequent restoration:

PAW PAW TOWNSHIP T.3 S.- R.14 W.  
CORNER COMMON TO SEC. 21 & 22, 27 & 28

- Jan. 1830 - Government - William Brookfield D.S.  
Set Post common to Sec. 21, 22, 27 & 28.  
12" Lynn - N 56 Deg E 8 lks.  
10" Lynn - S 56 Deg W 4 lks.
- March 1851 - J. H. Simmons, Sur  
Corner used to locate Territorial Rd. (B 1-12, B 4-77).
- Oct. 1871 - A. J. Pierce, Co Surveyor  
Found stake renewed with stake, stone & brick.  
No Old Wit visible.
- August 1951 - T. A. Smith, Co Surveyor  
Used corner
- April 1967 - W. Q. Smith - J. Boynton  
Found 1" pipe
- Jan. 1972 - W. Q. Smith, Co Surveyor  
Project for Village Treatment Plant. Seems a different point  
was used.
- April 6, 1972 - Found note by J. Boynton dated 4/6/72 tying an  
iron and a 1" pipe together at this location.  
Rec'd L1-P16 as 1/2" iron & in Rec'd survey.
- Oct. 1986 - D. Gilchrist, Co Surveyor  
Found & Used 1/2" iron & wit's.  
Rec'd Survey L9-P145
- Dec. 1990 - J. C. Hunt  
Found & Used pipe & tied the iron in. Corner rec'd L3-P180