

Dec 20 1 44 PM '99

7.00
8890 12/20 0104 10SURVEY

W 1/4 cor., Sec. 11

LAND CORNER RECORDATION CERTIFICATE
Filing Requirement of Act 74, Mich. P.A. 1979

For corners in PAW PAW TWP.
VAN BUREN
(County)

Located In: Corner Code #

1. Public Land Survey	T 3S. R 14W.	I-4
	T R	
	T R	
	T R	
2. Property Controlling in Section	S T R	
	S T R	
3. Miscellaneous Property in Sec.	S T R	
	S T R	

SURVEY & RECORDS

DEC 28 1999

SECTION

Register of Deeds Stamp & File Number

4. Lot No. _____, Recorded Plat _____
5. Private Claims _____

I, Allen H. McMachen, in a field survey on November 30 1999 hereby state that under requirements of P.A. 74, Michigan P.A. of 1970, the corner points mentioned in lines 1 and 2 above were in conformance with regulations and rules therefore as required in the current manual of survey instructions of the United States Department of the Interior, Bureau of Land Management or by a decree of a Court of Law and for that the corner points mentioned in lines 3, 4 and 5 above were in conformance with the rules of the Michigan Board of Land Surveyors or by a Decree of a Court of Law; established, re-established, monumented, recovered, found as expressed below:

NOTE: Not more than 2 corners, all in the same town and range, may be recorded on this certificate.

A	B	C	D	E	F	G	H	I	J	K	L	M
1												
2	6		5		4		3		2		1	
3												
4	7		8		9		10		11		12	
5												
6	16		17		16		15		14		13	
7												
8	19		20		21		22		23		24	
9												
10	30		29		28		27		26		25	
11												
12	31		32		33		34		35		36	
13												

A. Description of original monument and accessories and/or subsequent restoration:

- 1830 - William Brookfield, D.S., Set quarter Section post, 18" Wh. Oak S. 34° E. 87 lks. (57.42'), 18" Wh. Oak S. 49° 20' W. 18 lks. (11.88')
- 1871 - A.J. Pierce, D.S., Set a stone in place to agree with old stump (apparent witness) could find no stake, set oak stake and a number of little stones, 18" Wh. Oak N. 38° E. 72 lks. (47.52).
- 1899 - G. Mutchler, C.S., Stake and stones, no witnesses present, 17" Maple N. 31° 45' W. 68.25 lks. (45.05'), 14" Sugar S. 71° 20' E. 1.00 chs. (66.00')
- 1914 - W.H. Goss, D.S., Pipe. 17" Maple N. 31° 45' W. 68.25 lks. (45.05')
- 1923 - T.A. Smith, C.S., Found 1" iron pipe, 24" Maple N. 31° 45' W. 46.6' to centerline, 5" Catalpa S. 70° W. 52.0', Northwest to corner of stone foundation, S. 45° W. 44.9'
- 1968 - Smith & Smith, Inc., Found pipe down 6" - 60p spike to surface, 36" Maple - Northwest - 45.13' to tack and washer, East side, Power pole - Northeast - 52.58' to tack and washer on Southerly side, Northwest corner of barn foundation - Southwest - 44.9'
- 1973 - Smith & Smith, Inc., Found 3/4" pipe, 20" Maple - North 33.54' to tack & washer on East side, 20" Hickory - Northwest - 59.35' to tack & washer on East side, Railroad tie end post vineyard - South - Southwest - 89.37' to tack & washer on Northwest corner.

- 1974 - Allen McMachen, R.L.S., Found iron, T.P. - N. 35° W. 40.66', P.P. - N. 40° E. 52.56', T.P. - S. 50° E. - 44.16'
- 1974 - Smith & Smith, Inc., Pipe down 6" - 60p spike to surface, 36" Maple - Northwest - 45.13' to tack & washer on East side, Power pole - Northeast - 52.58' to tack & washer on Southerly side, Northwest corner barn foundation - Southwest - 44.9'
- 1978 - Terry J. Woldring, R.L.S., Tack & washer in power pole, N. 40° E. 52.58', 60p nail in 36" Maple N. 40° W. 45.23', Northwest corner of barn S. 45° W. 44.9'
- 1985 - D.R. Gilchrist, R.L.S., Pipe down 6" - 60p spike to surface, 36" Maple - Northwest - 45.13' to tab & washer on East side, Power pole - Northeast - 52.58' to tab and washer on Southerly side, Northwest corner of barn foundation - Southwest - 44.9'
- 1992 - John C. Hunt, R.L.S., Found pipe down 6" - 60p spike to surface, N. 45° W. 45.13' to nail in East side of 36" Maple, N. 45° W. 45.13' to nail in East side of 36" Maple, N. 45° E. 52.58 feet to tack and washer on Southerly side of power pole, Southwest - 44.90 feet to Northwest corner of barn foundation, S. 50° E. 44.20 feet to PK nail in Southwest face of pole.
- 1994 - D.R. Gilchrist, R.L.S., Found pipe and witnesses the same as in 1992.

B. Description of corner evidence found and/or method applied in restoring or reestablishing corner:

Found 60d nail in monument box per (2) 1992 witnesses. Removed 60d nail and found pipe directly under nail 1' below grade. Removed pipe and found what appears to be a boat spike directly under pipe. Top of spike is 2.5 feet below grade. Location of found pipe was ratified by the Van Buren County Remonumentation Peer Group on April 28, 1999.


C. Description of monument for corner and accessories established to perpetuate locating the position of the corner:

Location of found pipe is accepted as a careful and faithful perpetuation of the position of the original corner. Placed a 20" Standard Van Buren County Remonumentation Monument at location of found pipe and directly over boat spike left in place with monument box over, Accessories:

- Nail & Tab in S.E. side of U. Pole N. 40° E. 54.30'
- Nail & Tab in North side of 30" Maple S. 70° E. 64.35'
- Nail & Tab in East side of 12" Maple S. 30° W. 30.04'
- NW corner of foundation of old barn S. 50° W. 44.90'
- 3.7 feet South of centerline East and West road
- In line with centerline road to North

Ratified by Peer Group in accordance with P.A. 345 of 1998
Van Buren County Surveyor

Date 12-20-99 D. R. G.

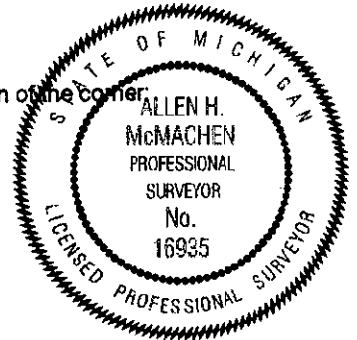

Signed by Allen H. McMachen
Surveyor's Michigan License No. 16935

Date 12/14/99

L. Dec 5 pg. 309