

SURVEY & REMONUMENTATION

LAND CORNER RECORDATION CERTIFICATE

JAN 11 1999

FILING REQUIREMENT OF ACT 74, MICH. P.A.1970

SECTION

FOR CORNERS OF--	LOCATED IN--	CORNER CODE NUMBER
1. PUBLIC LAND SURVEY _____ T. <u>3</u> ^{XXX} S., R. <u>14</u> ^{XXX} W. N 1/4 Post Sec 11 <u>Ray Ray Twp.</u>		J 3
2. PROPERTY CONTROLLING IN SECTION _____ , T. _____ S., R. _____ E. W.		
3. MISCELLANEOUS PROPERTY IN SECTION _____ , T. _____ S., R. _____ E. W.		
4. LOT NO. _____ , RECORDED PLAT _____		
5. PRIVATE CLAIMS _____		

FILED
OCT 1 9 14 AM '99
Mark A. Smith
VAN BUREN CO.
REGISTER OF DEEDS STAMP AND FILING NUMBER


I, Charles D. Lossie, do hereby certify that under requirements of P.A. 74, Michigan P.A. of 1970, the corner points mentioned in lines 1 and 2 above were, in a field survey on 9/18, 1998, established, re-established, monumented, re-monumented, recovered or restored as expressed below and in conformance with regulations and rules therefore as required in the current manual of survey instructions of the United States Department of the Interior, Bureau of Land Management or by a decree of a court of law. Furthermore, that the corner points mentioned in lines 3, 4 and 5 above were, in a field survey on _____, 19____, found, recovered, restored, established or re-established as expressed below and in conformance with the rules of the Michigan State Board of Registration for Land Surveyors or, by a Decree of a Court of law:

- A. Description of original monument and accessories and/or subsequent restoration:
- 5/1830-Government-William Brookfield, D.S. Established original monument 'stake'
 - 5/15/1900-George Mutchler, C.S. Stone:
Witnesses: 7" Butternut S 39°-15'E-24.42'
 - 18"Walnut-N63°W-5.28': 8" Sugar Maple-S 66°-30'W-58.74'
 - 1900!W.H. Goss, D.S.-Stone:
Witnesses: 10"Walnut-N 63°W-54.12': 7" Butternut-S 39°-E-24.42'
 - 1/4/1940-T.A.Smith, C.S.: Stone:
Witnesses: 8"Norway Spruce N40°E-51.5' to C₁
 - 8/4/1971-W.Q.SMITH, C.S.(D.A.Middleton, R.L.S.) Pipe:
Witnesses: 36"Maple S75°W-58.79' : 12" Pine-N45°E-51.39': NW Cor Brick House S30°E-99.27'
 - 8/13/1976-A.H.McMachen, R.L.S. Iron:
Witnesses: Tree S70°W-58.85': 2" Pipe-South 32.70': NW Cor of House-S30°E-99.25'
 - 3/27/1979-D.R.P.Hs, R.L.S.(Gove) Recorded Survey (Liber 8-Pg 62)
Shows Cor (pipe & gave witnesses same as W.Q. Smith 8/4/1971 Recorded Survey (Liber 8-Pg 62)
Shows Cor(pipe) and gives witnesses same as W.Q. Smith 8/4/1971
 - 8/20/1980-D.R.Gilchrist, C.S. Recorded Survey (Liber 8-Pg 306)
Witnesses: 38" Maple-S50°W-58.50'
8"Maple-S46°E-73.40' to C₁
6"Spruce-N43°E-64.00' to L₁
1' South of L₁
 - 10/18/1998 Dwg shows Cor and same as Gilchrist 4/27/88

B. Description of corner evidence found and/or method applied in restoring or re-establishing corner:
Found 3/4' pipe with 60d penny spike in top over boat spike
Found pointed stone down 15" stone is .20 East and .25 North of surface monument.
The corner was approved for remonumentation at the July Peer Group Meeting and is accepted as the best available evidence of the position of the original corner.

C. Description of monument for corner and accessories established to perpetuate locating the position of the corner:
Set Harrison marked over pointed stone in monument Box
NW Cor brick house S 30° E 99.35'
Red Maple 10" s-50° E 72.80'
18" Spruce N-50° E 51.65'
18" Spruce N-20° E 97.60'

Ratified by Peer Group in accordance with P.A. 345 of 1990
Van Buren County Surveyor
Date D.R.G. 10/1/98

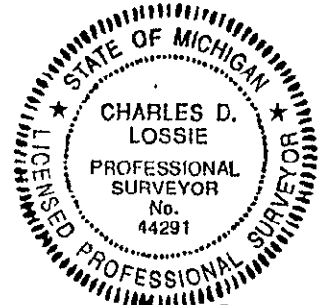

SIGNED BY Charles D. Lossie DATE 10-1-98


FOR STATE AND UNITED STATES AGENCIES:
SIGNED BY _____ DATE _____
CHIEF OF SURVEY PARTY

APPROVED AND SIGNED BY _____ DATE _____
MICHIGAN REGISTERED LAND SURVEYOR (SEAL)

SURVEYOR'S MICHIGAN REGISTRATION NO. _____ Liber 5 pg 101

9977 10/01 0104 10SURVEY 7.00