

L 4 Pg 133

VAN BUREN COUNTY REMONUMENTATION PROGRAM

LAND CORNER RECORDATION CERTIFICATE

Filing Requirement of Act 74, Mich. P.A. 1970

For corners in

Van Buren <small>(County)</small>	Located In: N $\frac{1}{2}$ Post Paw Paw Twp.	Corner Code #
1. Public Land Survey Sec. 14	T 3 S. R 14 W.	J-5
	T _____ R _____	_____
	T _____ R _____	_____
	T _____ R _____	_____
2. Property Controlling in Section	S _____ T _____ R _____	_____
	S _____ T _____ R _____	_____
3. Miscellaneous Property in Sec.	S _____ T _____ R _____	_____
	S _____ T _____ R _____	_____
4. Lot No. _____, Recorded Plat _____		
5. Private Claims _____		

SURVEY & REMONUMENTATION

JUN 14 1994

COMMISSION

Register of Deeds Stamp & File Number

I, John C. Hunt, PS, in a field survey on March 4, 1994, do hereby certify that under requirements of P.A. 74, Michigan P.A. of 1970, the corner points mentioned in lines 1 and 2 above were in conformance with regulations and rules therefore as required in the current manual of survey instructions of the United States Department of the Interior, Bureau of Land Management or by a decree of a Court of Law and/or that the corner points mentioned in lines 3, 4 and 5 above were in conformance with the rules of the Michigan Board of Land Surveyors or by a Decree of a Court of Law; established, re-established, monumented, re-monumented, recovered, found as expressed below:

NOTE: Not more than 4 corners, all in the same town and range, may be recorded on this certificate.

A	B	C	D	E	F	G	H	I	J	K	L	M
2	6	5	4	3	2	1						
3												
4	7	8	9	10	11	12						
5												
6	18	17	16	15	14	13						
7												
8	19	20	21	22	23	24						
9												
10	30	29	28	27	26	25						
11												
12	31	32	33	34	35	36						
13												

A. Description of original monument and accessories and/or subsequent restoration:

5/1830 Gov.: Wm. Brookfield DS corrected $\frac{1}{4}$ post to 40.06 ch, 2643.96'. Wit.: 18" Wht. Oak S.13°W. 78 lk, 51.48'; 14" Wht. Oak N83°30'W 84 lk, 55.44'. 5/15/1900 G Michler CS, stone & stake, no wit. 10/28/1949 TA Smith CS, 1946-1949 2 drawings show cor. & dist. N. to C/L of hwy. 311.52' 10/26/1959 WJ Smith CS drawing shows cor. as per TA Smith 1949 drawing. 2/7/1966 Drawing shown like prior work. 2/14/1972 Rec. Cert. L.1 p.438. 3/11/1974, 8/4/1975, & 6/21/1978 notes show cor. 3/13/1974 Rec. survey L.5 p.48. 7/11/1978 T Woldring RLS rec. survey L.8 p.68 w/ wit. 1/8/1981 JC Hunt RLS Surveys that show cor.: 1/8/1981, 6/21/1985, 7/13/1990, & 7/1/1992. Rec. surveys showing cor.: L.9 p.205, L.9 p.207, L.9 p.340. 10/1/1985 DR Gilchrist CS Notes show cor. as 1" Pipe. 1/30/1990 his drawing shows 1" pipe cor. & wit. 5/12/1993 JC Hunt PS Rec. survey L.9 p.423.


B. Description of corner evidence found and/or method applied in restoring or reestablishing corner:

J-5 Quarter post common to Sections 11 & 14, T3S-R14W, Paw Paw Township.
Corner evidence found: $1\frac{1}{2}$ " iron pipe in ring of stones. Replaced with Harrison Marker.

THIS GOVERNMENT MONUMENT WAS RESTORED WITH APPROVAL OF THE VAN BUREN COUNTY REMONUMENTATION PEER GROUP OF SURVEYORS AT A MEETING HELD ON February 23, 1994, AND IS ACCEPTED AS A CAREFUL AND FAITHFUL PERPETUATION OF THE POSITION OF THE ORIGINAL CORNER.

Ratified by Peer Group in
accordance with P.A. 345 of 1990
Van Buren County Surveyor

Date 6/9/94 

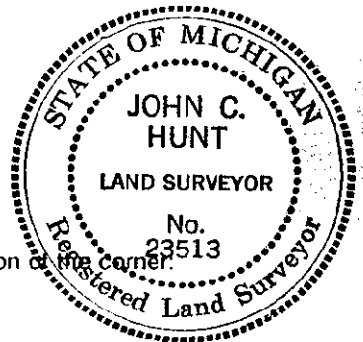

C. Description of monument for corner and accessories established to perpetuate locating the position of the corner:

J-5 HARRISON MARKER

- S.85°W. 41.13' PK nail in North face of wood post.
- East 5.22' Set nail & tag in South face of 9" Box Elder.
- S.70°E. 7.58' Set nail & tag in SW face 16" quadruple Box Elder.
- N.25°E. 28.75' Set nail & tag in West face of 6" Wild Cherry.
- N.70°W. 139.60' SE corner of brick house.

Set Survey Marker Sign Post 0.5' South of Harrison Marker.

Signed by John C. Hunt, P.S. Date March 10, 1994
Surveyor's Michigan License No. 23513